


T. 36 S., R. 3 W., W.M.

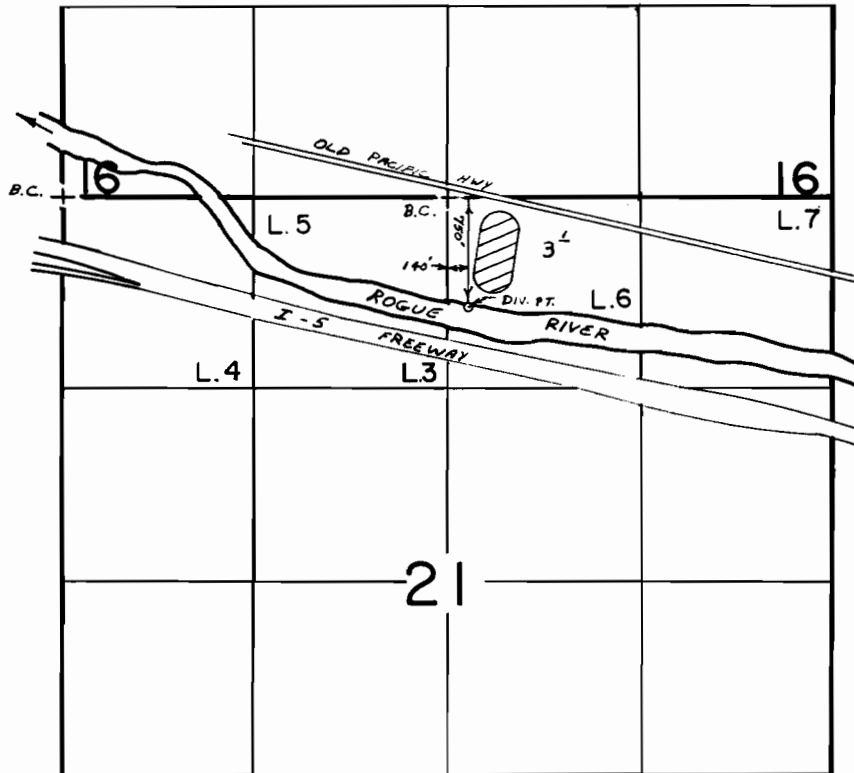

Scale : 4" = 1 mile

FINAL PROOF SURVEY
UNDER

Application No. 51661... Permit No. 38953.....
IN NAME OF

SCHOOL DIST. 6-C : HANBY JR. HIGH SCHOOL

Surveyed Oct. 27, 1981, by Bruce R. Sund