


T. 40 S., R. 3 W., W. M.

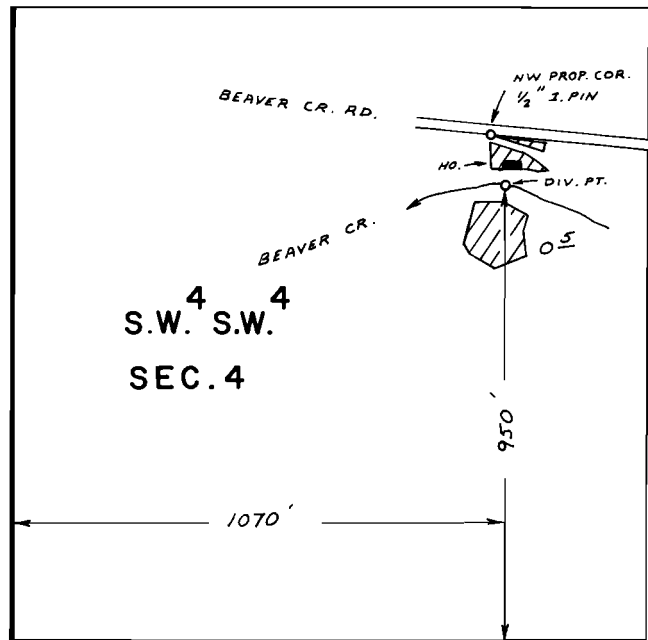

SCALE: 1" = 400 FT.

**FINAL PROOF SURVEY**  
UNDER

Application No. 51902 Permit No. 39057  
IN NAME OF

Christian G. and Marjorie S. Gunther

Surveyed APR. 24 1979, by B. SUND