


T.36 S., R.4 W., W.M.

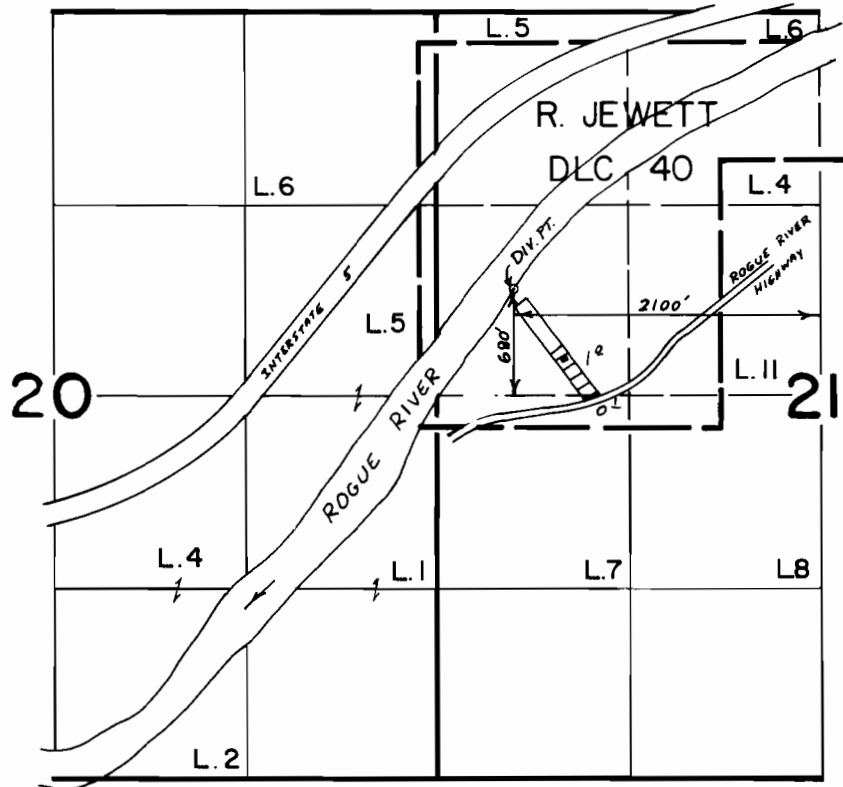

Scale 4" = 1 Mile

**FINAL PROOF SURVEY**  
UNDER

Application No. 52.7.63. Permit No. 39.720...  
IN NAME OF

F. E. & MARION P. HUCHENDORF

Surveyed NOV. 24, 1981, by BRUCE R. SUND