


T. 33 S., R. 1 W., W.M.

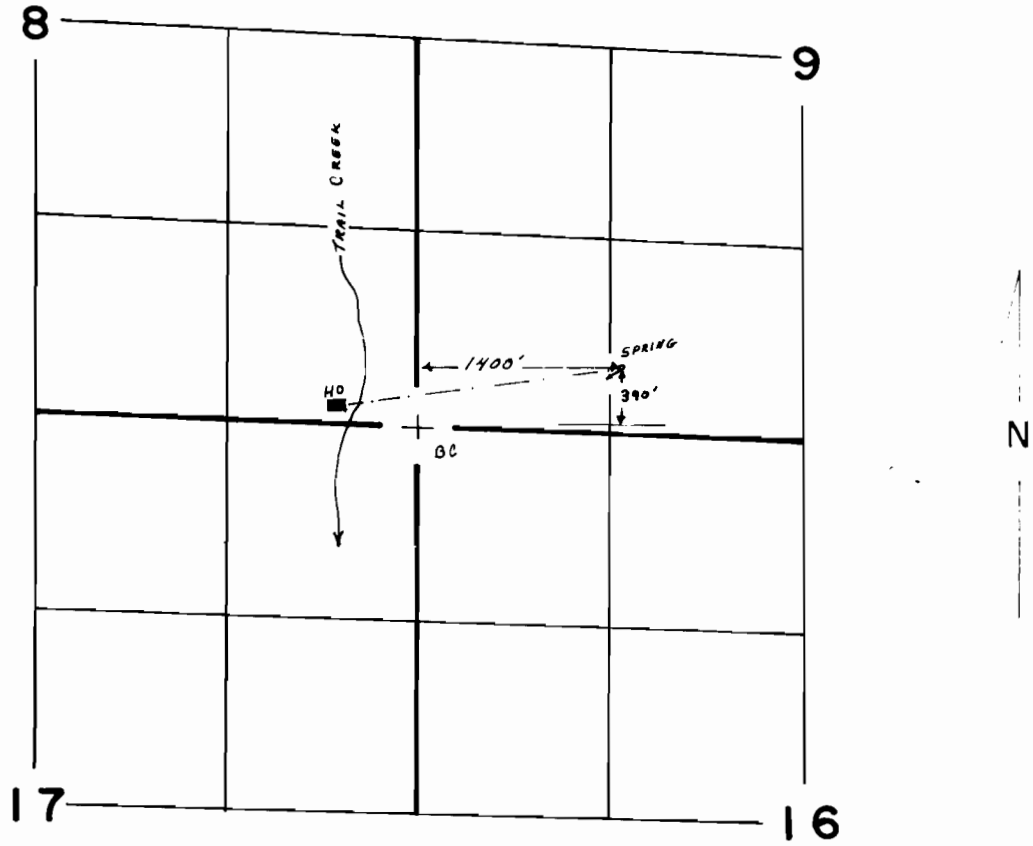

SCALE: 4" = 1 MILE

FINAL PROOF SURVEY UNDER

Application No. 52794 Permit No. 39849
IN NAME OF

NANCY L. GORDON

Surveyed SEP. 11. 1985, by B. S. JAMES.