


T. 34 S., R. 1 W., W.M.  
SEC. 3  
SW 1/4 SE 1/4

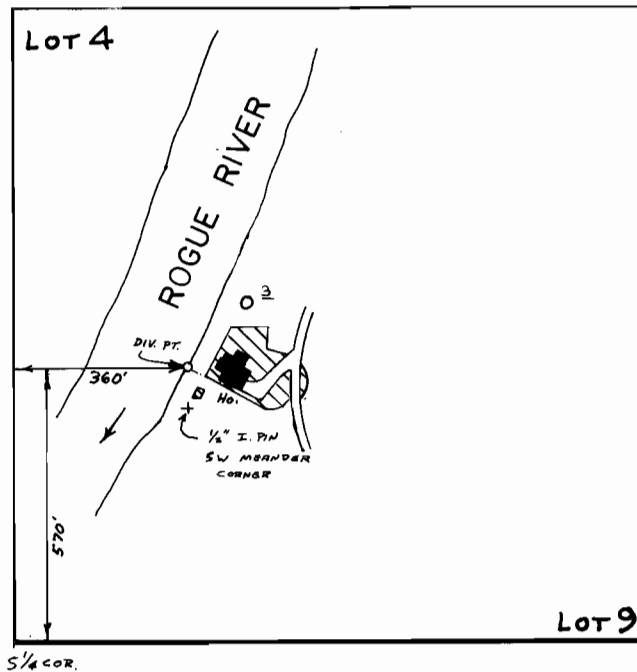

SCALE : 1" = 400'

**FINAL PROOF SURVEY**  
UNDER

Application No. 54063. Permit No. 40432.....  
IN NAME OF

.....EMMA LEE GRANGER.....

Surveyed SEPT. 10, 1981., by BRUCE R. SUND