


T. 35 S., R. 1 W., W.M.

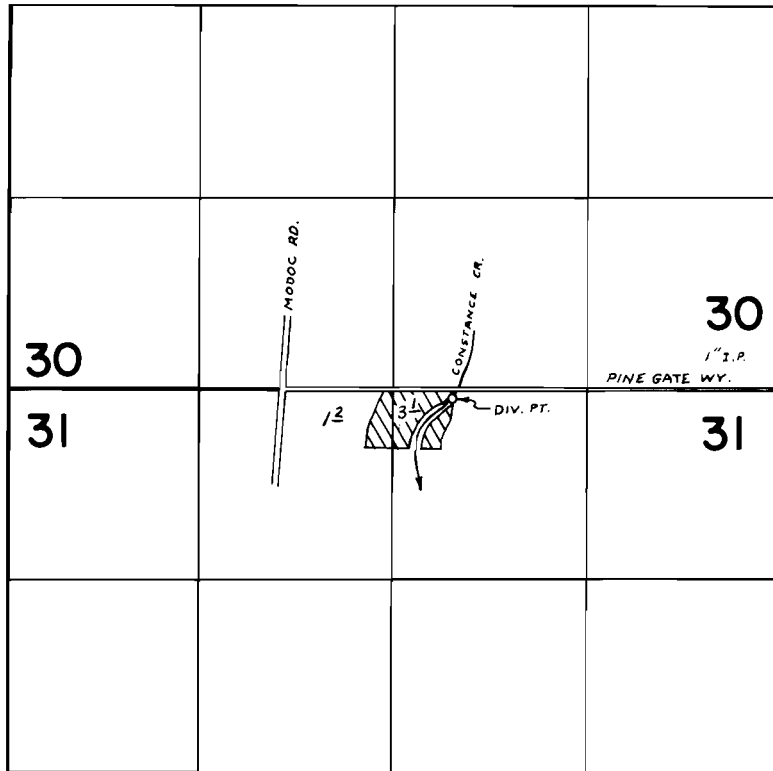

DIV. PT. LOC.: 70' S. of 410' E. FROM N. 1/4 COR. SEC. 31

FINAL PROOF SURVEY UNDER

Application No. 54370 Permit No. 40749
IN NAME OF

GLEN R. SMITH

Surveyed JUN. 1 1978 by B. SUND
NOV. 19 1985 by S. JAMES