


T. 35 S., R. 4 W., W.M.

Sec. 10

SE 1/4 SE 1/4

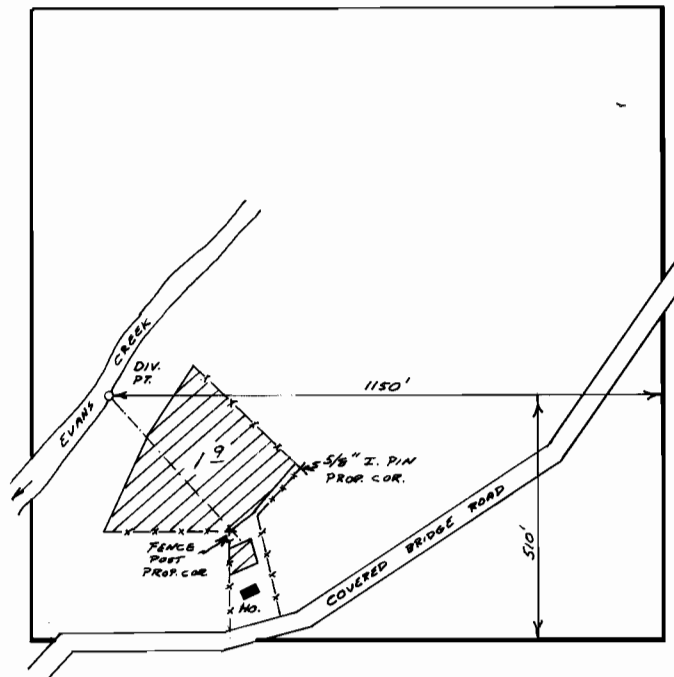

Scale : 1" = 400'

FINAL PROOF SURVEY
UNDER

Application No. 55020. Permit No. 41275....
IN NAME OF

.....ALVA.....S.....BLACK.....

Surveyed Aug. 27, 1981., by Bruce R. Sund