


T.39 & 40 S.R.3 W.W.M.

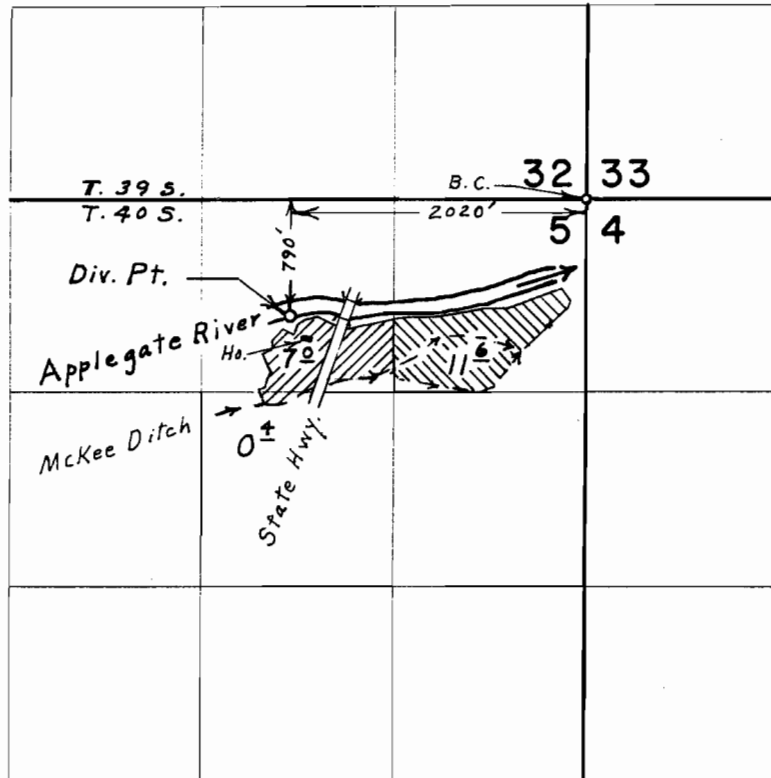

Primary 
Supplemental 

FINAL PROOF SURVEY
UNDER

Application No. 37730 Permit No. 28125
IN NAME OF

DAVID B. WINNINGHAM

Surveyed Sept. 21, 1971, by L. E. Gould