


T. 34 S., R. 1 W., W.M.  
SEC. 10

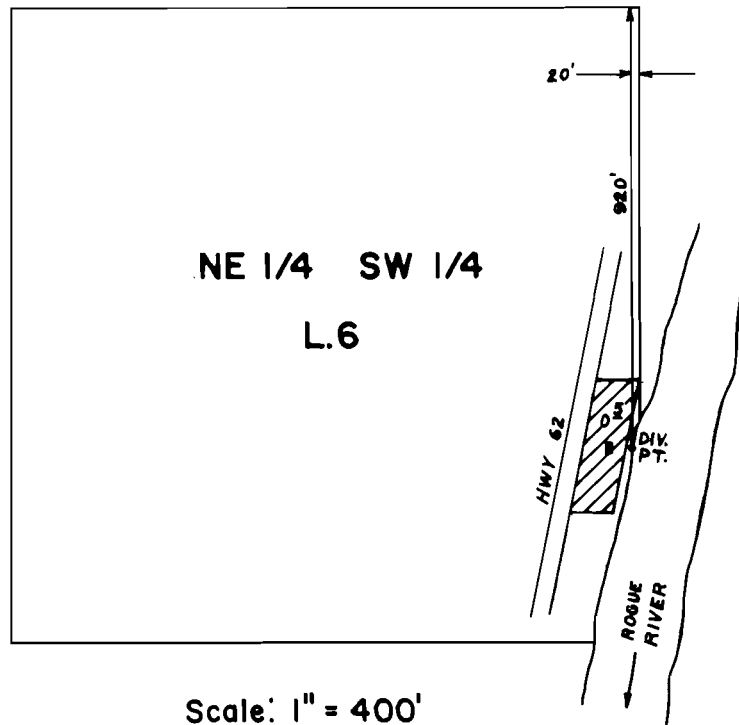

Scale: 1" = 400'

**FINAL PROOF SURVEY**  
UNDER

Application No. **56825** Permit No. **42670**...  
IN NAME OF

**.LETHA...VAN.DER.LINDEN...&/or...JOHN L. WEAVER**

Surveyed **NOV...18. 19.81.**, by **BRUCE R. SUND**