


T. 33 S., R. 2 E., W.M.

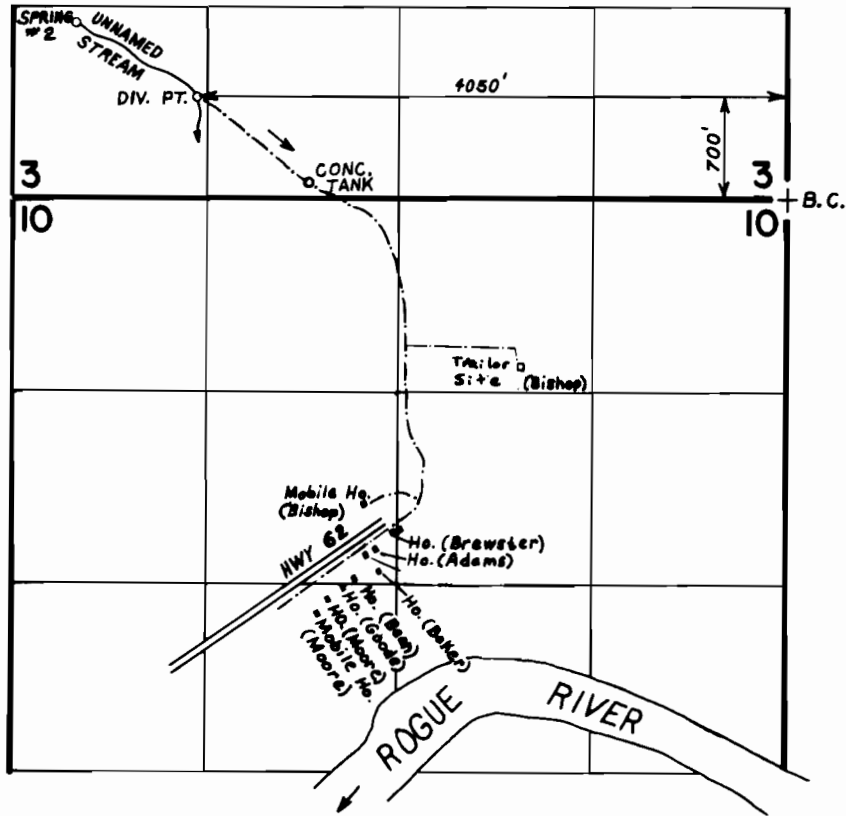

SCALE: 1"=1320'

FINAL PROOF SURVEY UNDER

Application No. **49146** Permit No. **43185**
IN NAME OF

...N.Y.E... SPRING... WATER... SYSTEM...

Surveyed **MAY 26 1983**, by **B. S. JAMES**