


T. 36S., R. 3W., W. M.

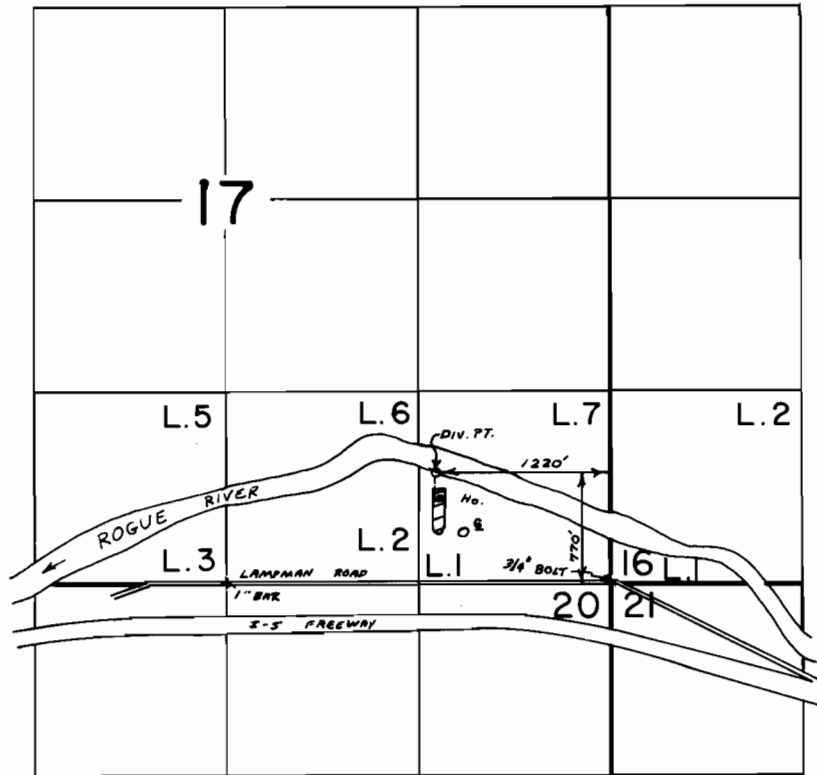

Scale 4"=1 mile

FINAL PROOF SURVEY
UNDER

Application No. 59854. Permit No. 45128.....
IN NAME OF

JOSEPH DAVID and/or BETTE S. HADDAD

Surveyed Oct. 27, 1981, by Bruce R. Sund