


T. 33 S., R. 1 W., W.M.

SEC. 35

SEC. 36

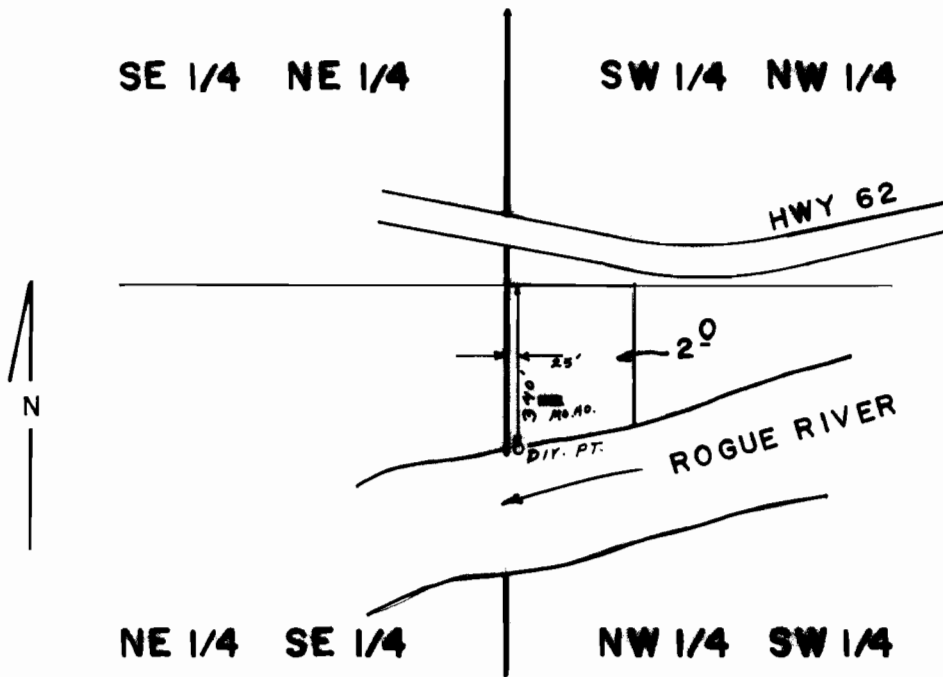

SCALE: 1" = 400'

FINAL PROOF SURVEY
UNDER

Application No. 59777 Permit No. 45305...
IN NAME OF

CAROL...J...B/OR...RICHARD...F...WINTER

Surveyed O.C.T..15.. 1985, by B...S...JAMES..