



T. 38 S., R. 3 W., W. M.

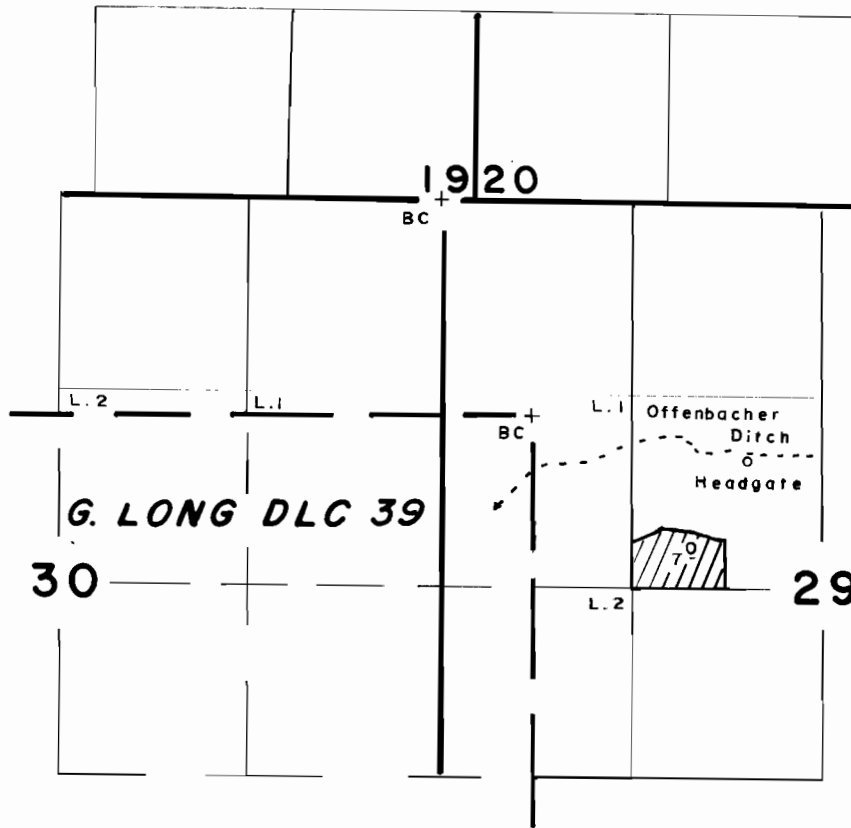

SCALE: 4" = 1 MILE

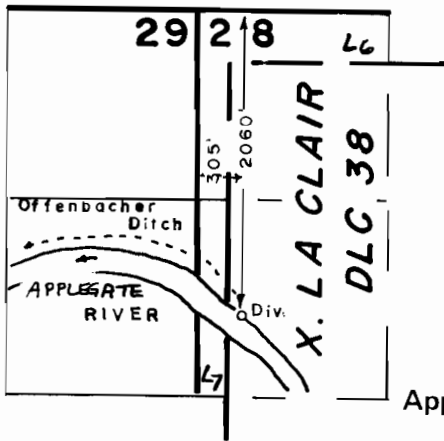

**FINAL PROOF SURVEY**  
UNDER

Application No. 62166 Permit No. 46025  
IN NAME OF

**ARTHUR & FRANCES M. CORNETTE HUNTING**

Surveyed JUNE.12. 19.85, by B. S. JAMES.....