
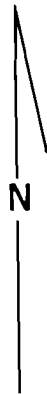


T. 33 S., R. 1 W., W. M.

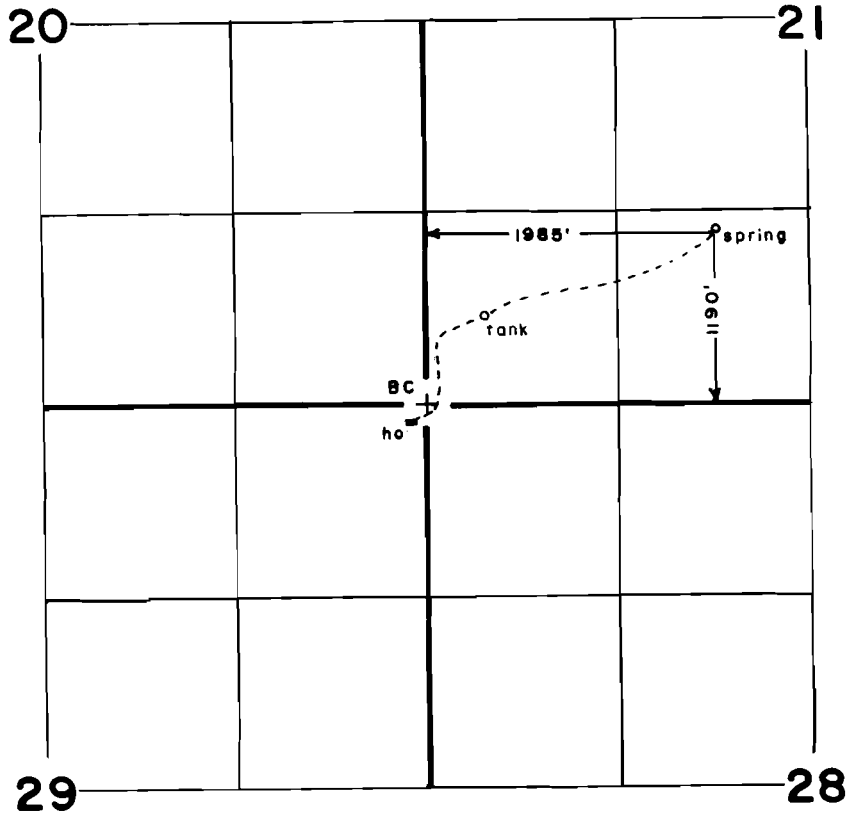

SCALE: 1" = 1320'

**FINAL PROOF SURVEY**  
UNDER

Application No. **63643** Permit No. **46872**  
IN NAME OF

**CHARLES MADDEN**

Surveyed **SEP. 10. 1985**, by **B. S. JAMES**