



T. 33 S., R. 2 E., W. M.

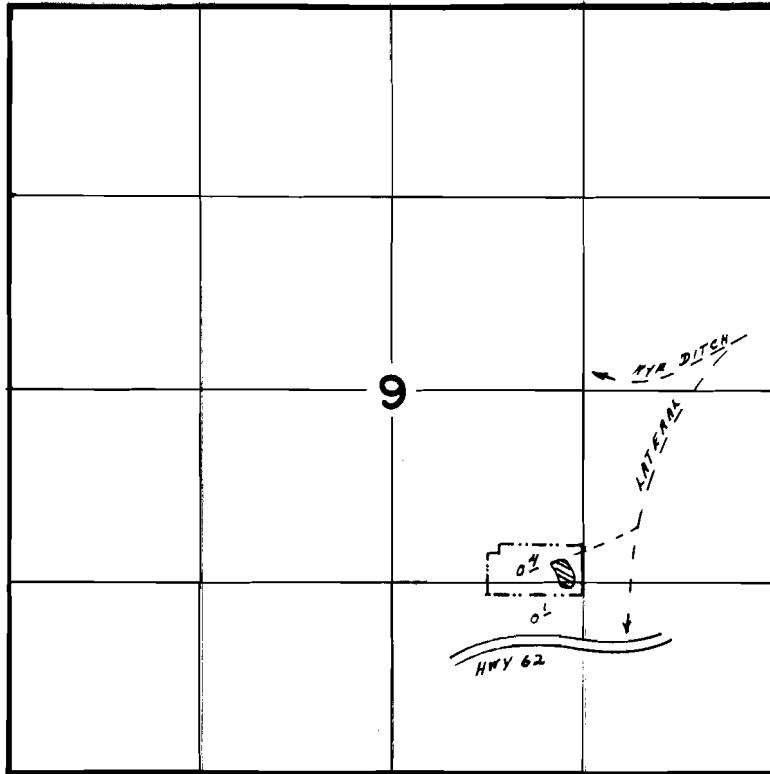

T. 32 S., R. 3 E.

SCALE: 1" = 1320'

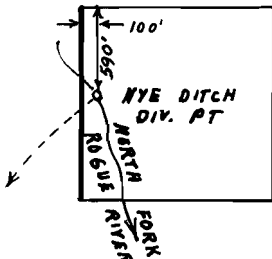

NW 14 SW 14
SEC. 29

FINAL PROOF SURVEY
UNDER

Application No. 6.3.7.9.5. Permit No. 4.7.1.3.0....
IN NAME OF

STANLEY & GWEN SNOOK

Surveyed O.C.T. 16. 19.85, by B. S. JAMES.