


T. 35 S., R. 1 W., W.M.

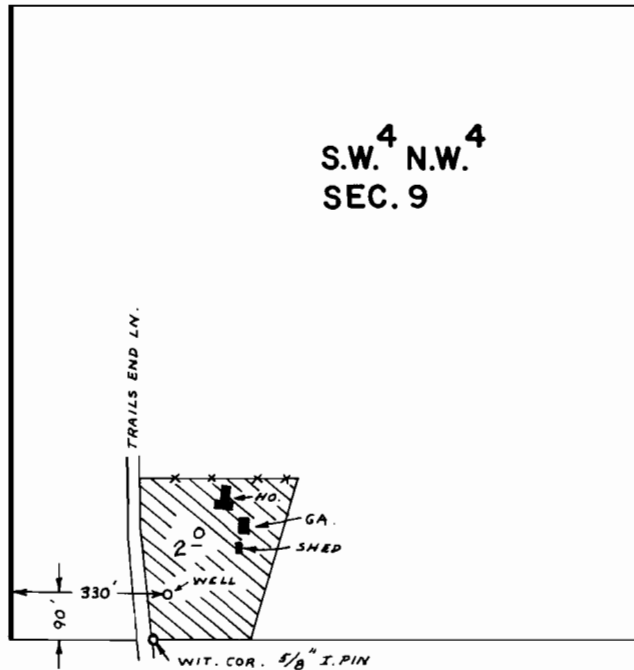

SCALE: 1" = 400 FT.

FINAL PROOF SURVEY
UNDER

Application No. G-6639 Permit No. G-5685
IN NAME OF

WARREN J. & SHARON L. FRAZIER

Surveyed JUN. 22 1979, by B. SUND