


# T. 39S., R. 2E., W.M.

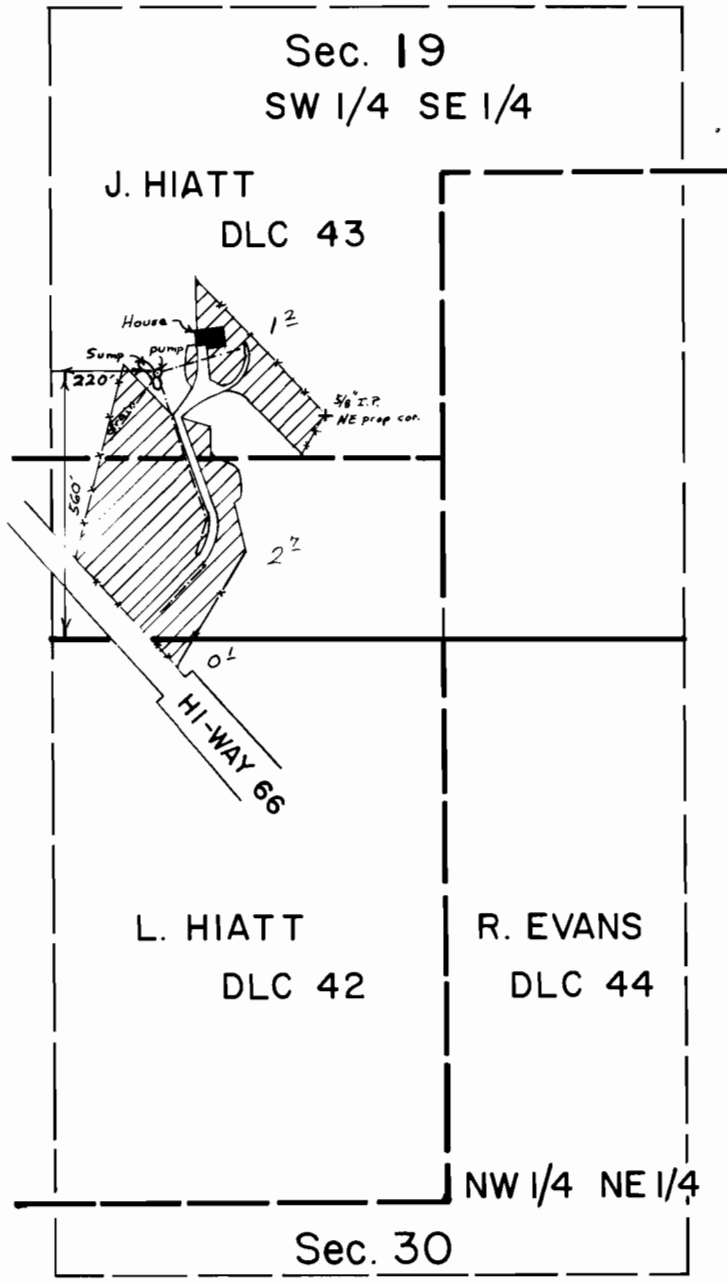

Scale: 1"=400'

## FINAL PROOF SURVEY UNDER

Application No. G-7954 Permit No. G-7332...  
IN NAME OF

WILLETT, E. and/or JOANNE K. WHITE

Surveyed Aug. 4, 1981, by B.R. SUND