


T. 38 S., R. 1 W. W.M.

Sec. 26

NW 1/4 NE 1/4

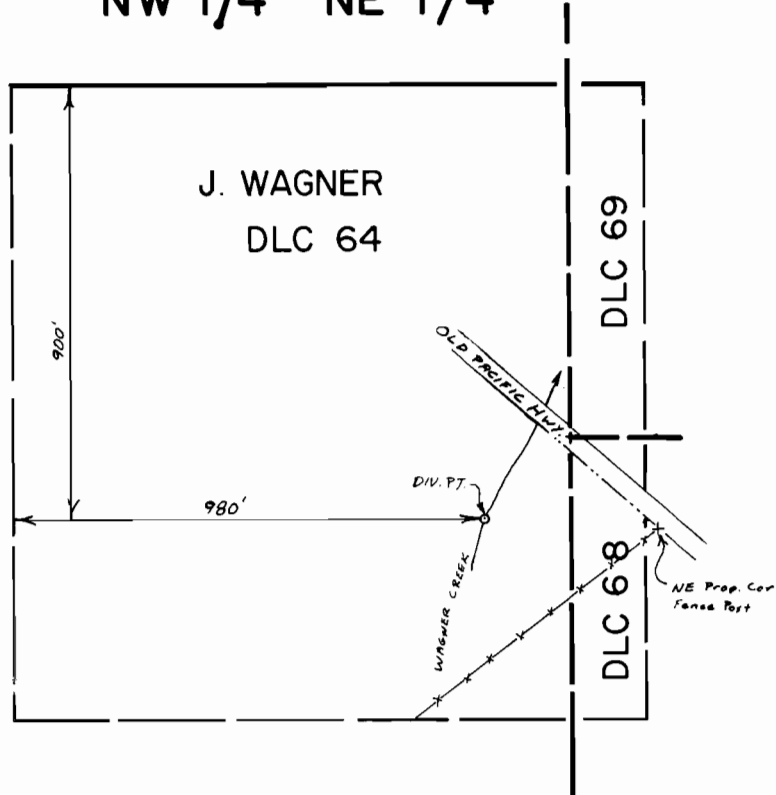

Scale : 1" = 400'

FINAL PROOF SURVEY

UNDER

Transfer No. H-180

Application No. Permit No.

IN NAME OF

..... WYLDER L. HOOKE

Surveyed Aug. 4, 1981, by B.R. SUND