


T. 38S., R. 5W., W.M.

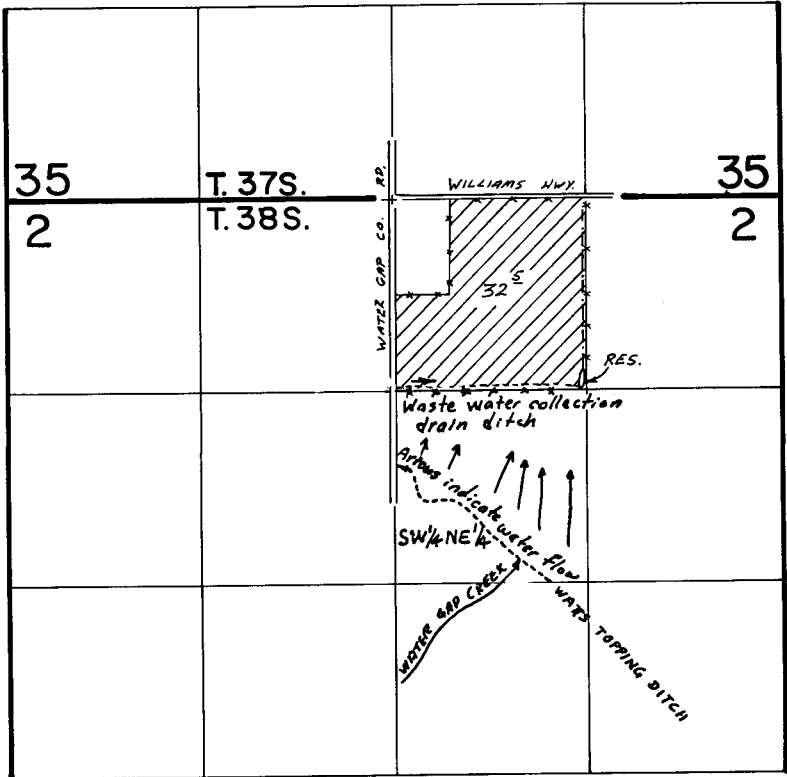

RES. LOC. = 1260'S & 1300'E FROM N 1/4 COR. SEC. 2.

Scale 1"=1320'

RECEIVED

OCT 20 1986

WM DIST. 14
GRANTS PASS, ORE

FINAL PROOF SURVEY
UNDER

R-53372 R-6343

Application No. 53373 Permit No. 39595.....
IN NAME OF

JOHN R. WOOD

Surveyed July 13, 1978, by B.R. SUND
Sept. 16, 1985, B.S. JAMES

DHM
PTS - 1978-14A
41033-179-109R

bsi