


T. 38S., R. 5W., W.M.

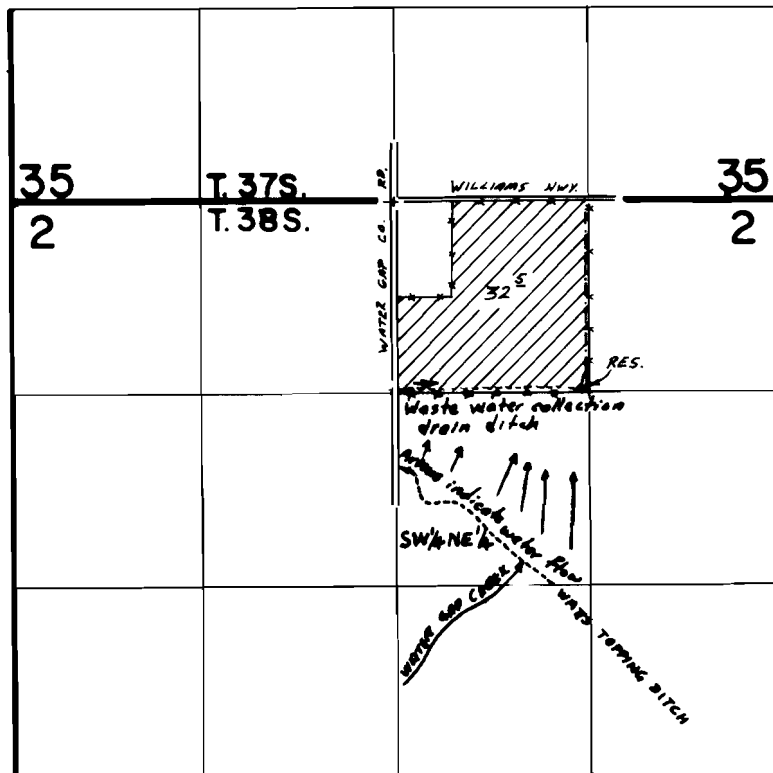

RES. LOC. = 1260'S & 1300'E FROM N 1/4 COR. SEC. 2.

Scale 1"=1320'

FINAL PROOF SURVEY UNDER

R-53372

R-6343

Application No. **53373**, Permit No. **39595**.....
IN NAME OF

JOHN R. WOOD

Surveyed **July 13**, 19**78**, by **B.R. SUND**.....
Sept. 16, 19**85**, **B.S. JAMES**

DHM
PTS-1978-14A
41033-179-109R

bsi