



T.38S., R.5W., W.M.

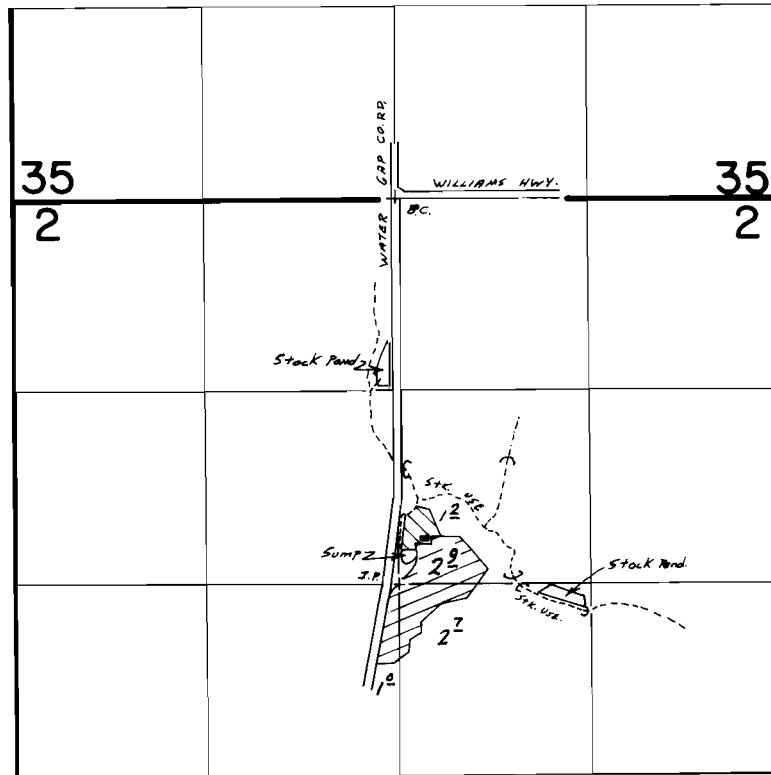

Sump: 180' N & 2600' W FROM E/4 COR. SEC. 2.

T.38S., R.5W., W.M.

Scale 1" = 1320'

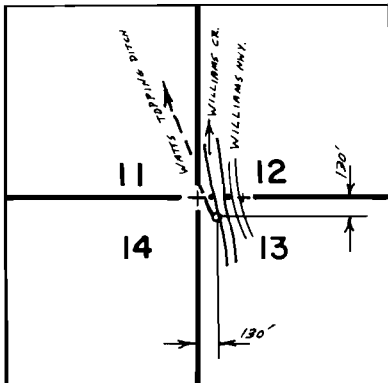

- ⊗ PRIMARY
- ⊗ SUPPLEMENTAL

FINAL PROOF SURVEY UNDER

G-7998 G-7702
Application No. 55656.. Permit No. 41694.....
IN NAME OF

.....JOHN R. WOOD.....

Surveyed July 13, 1978, by B.R. SUND.....
Sept. 16, 1985, B.S. JAMES