



T.38S., R.5W., W.M.

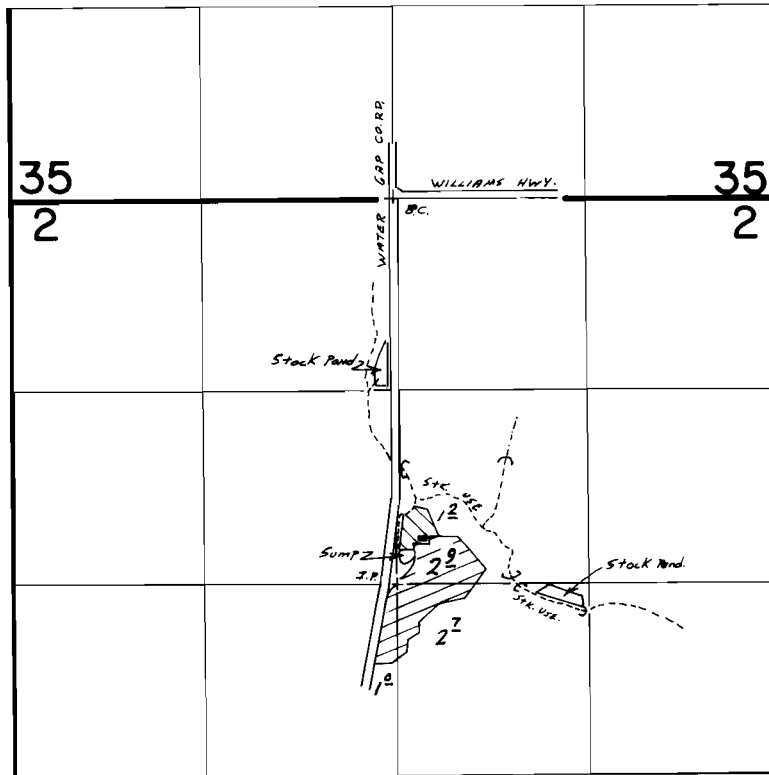

SUMP: 180' N & 2600' W FROM E/4 COR. SEC. 2.

T.38S., R.5W., W.M.

Scale 1" = 1320'

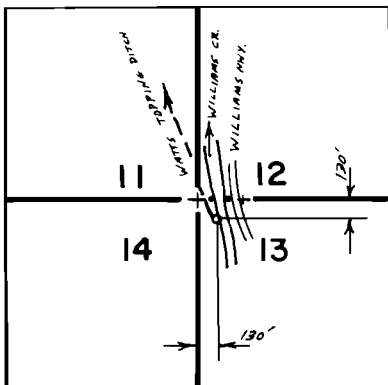

FINAL PROOF SURVEY UNDER

G-7998 G-7702
Application No. 55656 Permit No. 41694
IN NAME OF

JOHN R. WOOD

Surveyed July 13, 1978, by B.R. SUND
Sept. 16, 1985, B.S. JAMES

PRIMARY
SUPPLEMENTAL