


T.40 S.R.8 W.W.M.

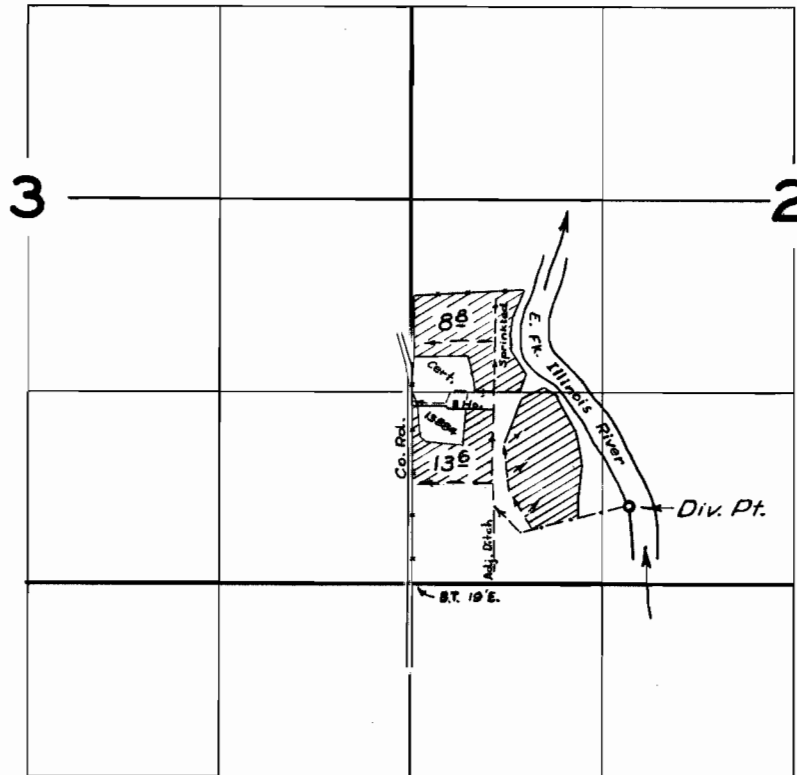

FINAL PROOF SURVEY UNDER

Application No. 29163 Permit No. 23329
IN NAME OF

B. F. & Mary P. Randolph

Surveyed 17 July 1959, by M. Bish