


T. 37 S., R. 7 W., W.M.

for G 3228:

////// supplemental

//// primary

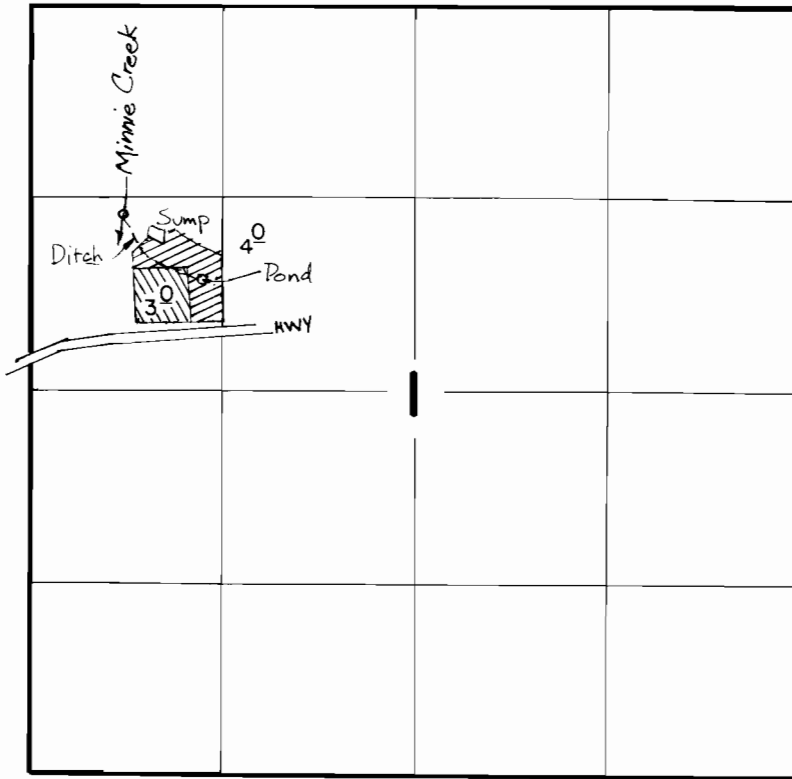

MINNIE CREEK Div. Pt. 120' S. & 680' W.
SUMP Div. Pt. 240' S. & 450' W.
POND Div. Pt. 560' S. & 150' W.
All located from N.E. Cor. S.W. 1/4 N.W. 1/4 Sec. 1.

FINAL PROOF SURVEY

UNDER

41355

30892

Application No. G.3228 Permit No. G.3036....

IN NAME OF

.....Robert and Jean Sweat.....

Surveyed AUG. 13, 1982, by B. S. JAMES.....