


T. 39 S., R. 8 W., W. M. .

Section 26

NW 1/4 SW 1/4

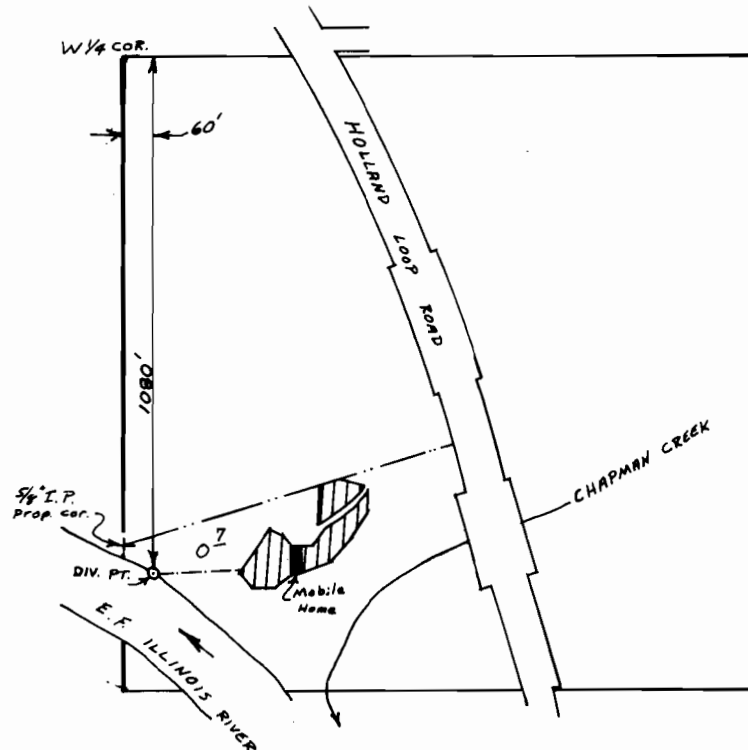

Scale: 1" = 400'

FINAL PROOF SURVEY
UNDER

Application No. 52791... Permit No. 37804...
IN NAME OF

CARL A. & JUNE V. SPIETH

Surveyed April 30, 1980, by B.R. SUND.....