


T.37S., R.5W., WM.

T.38S., R.5W., W.M.

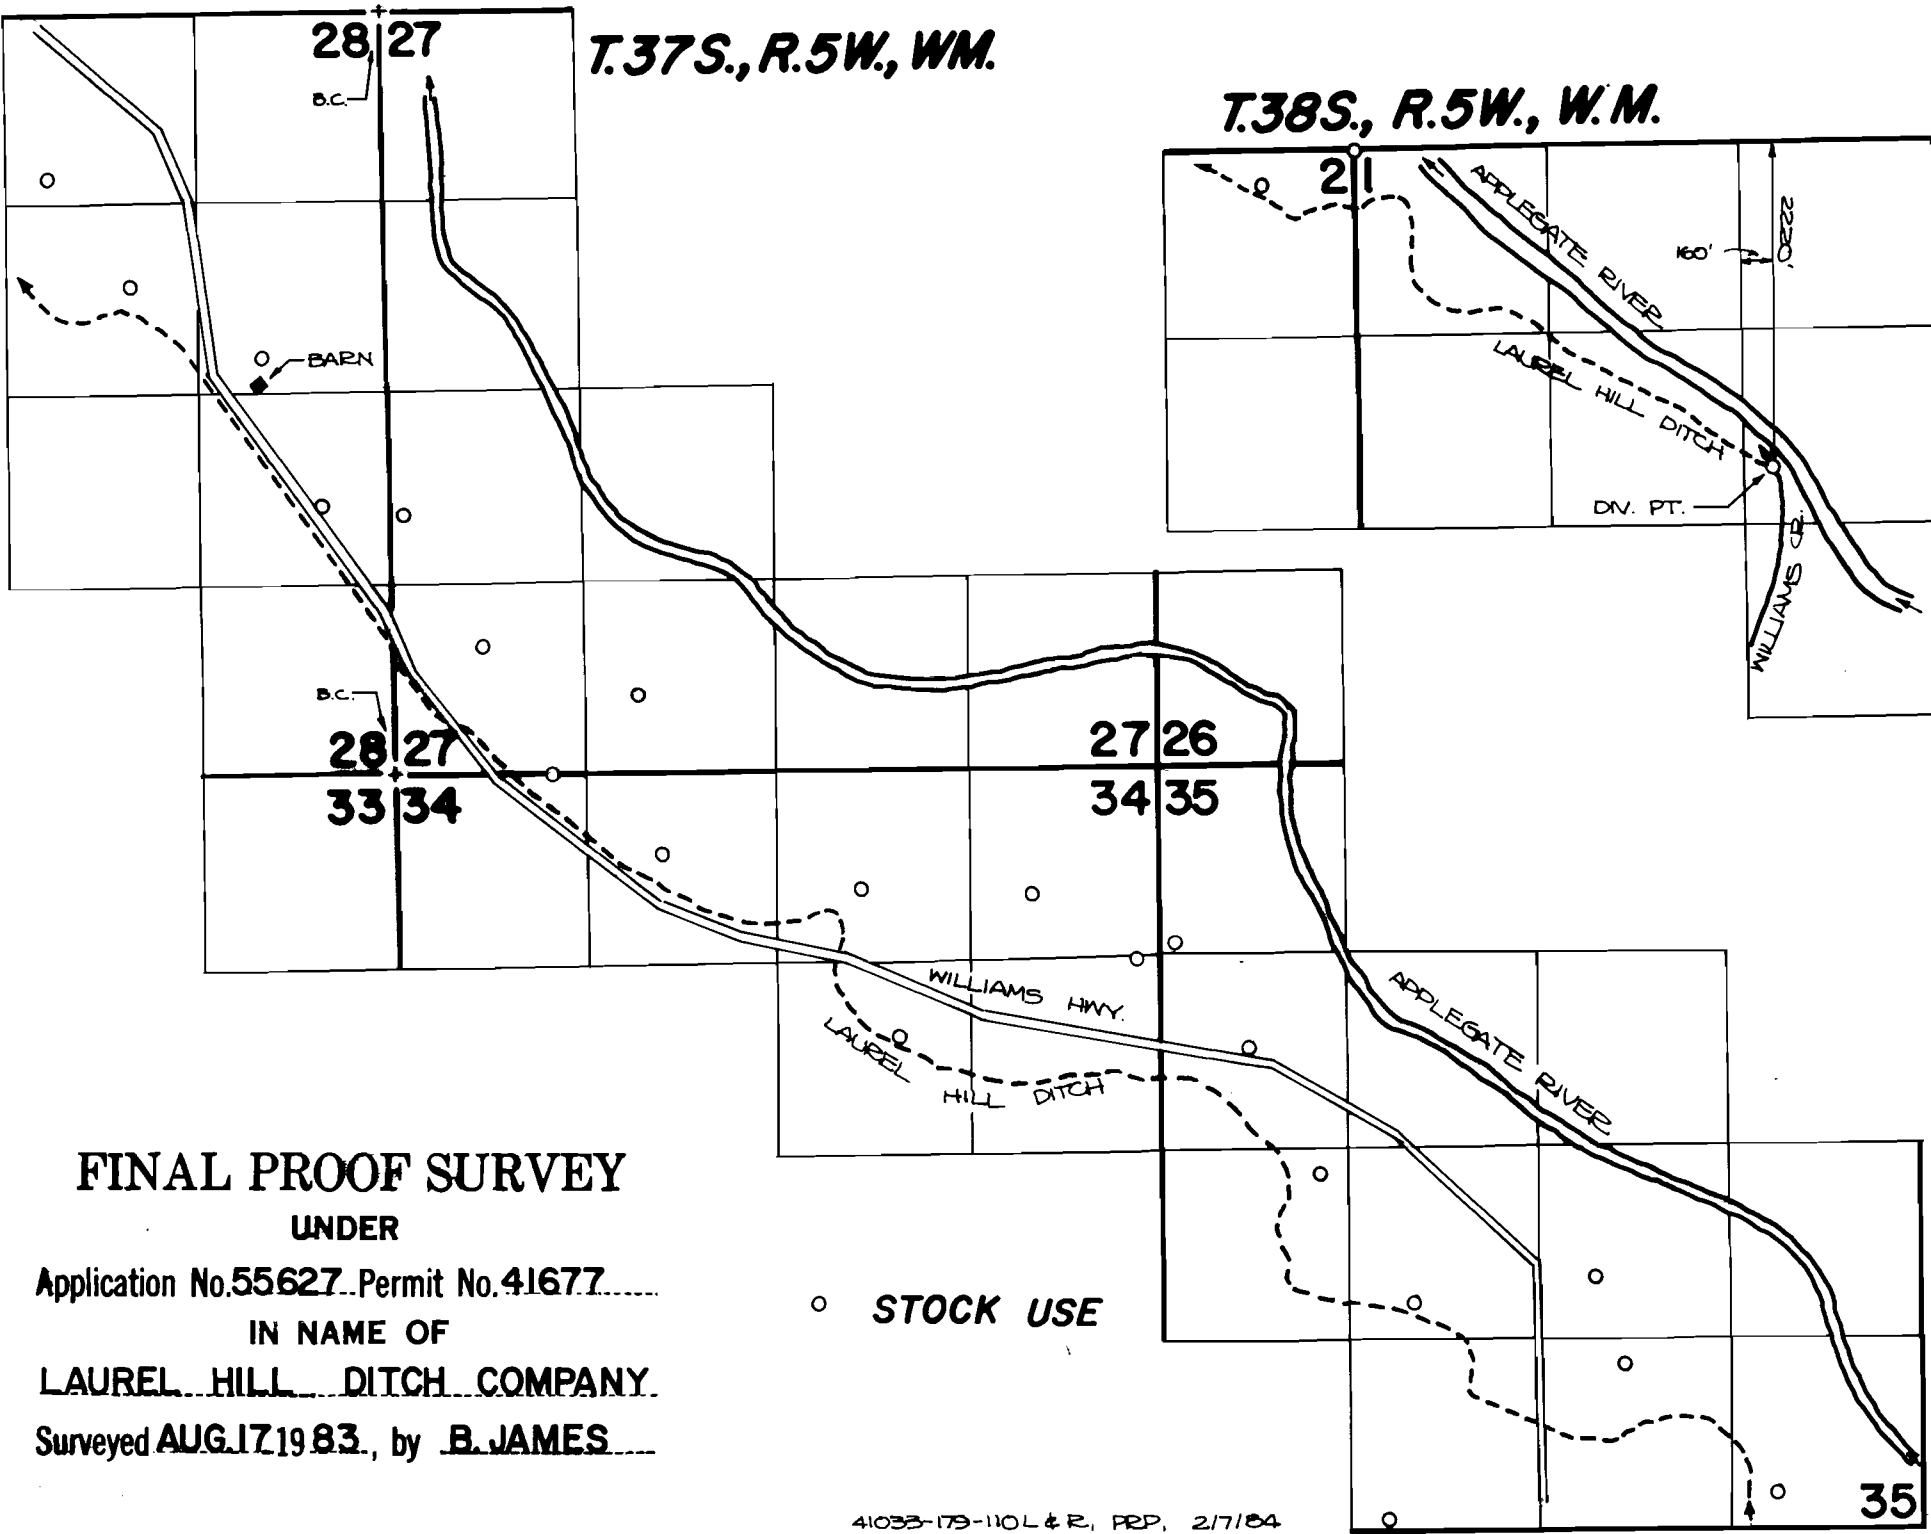

FINAL PROOF SURVEY

UNDER

Application No. 55627 Permit No. 41677

IN NAME OF

LAUREL HILL DITCH COMPANY

Surveyed AUG. 17 1983, by B. JAMES

○ STOCK USE