


T. 41 S., R. 9 W., W.M.

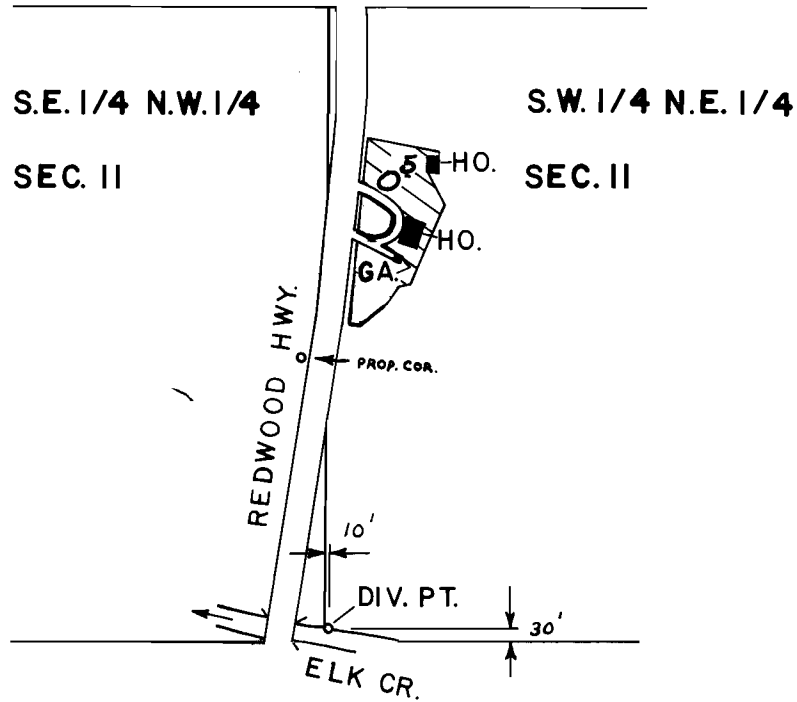

SCALE : 1" = 400 FT.

FINAL PROOF SURVEY
UNDER

Application No. 56676 Permit No. 43337
IN NAME OF

DONALD W. DAY, SR.

Surveyed JUN. 13 1979, by B. SUND

K.J.M.

PTS.-1979-14-B