


T.39S., R.8W., W.M.

RECEIVED

OCT 20 1986

WM. DIST. 14
GRANTS PASS, COKE

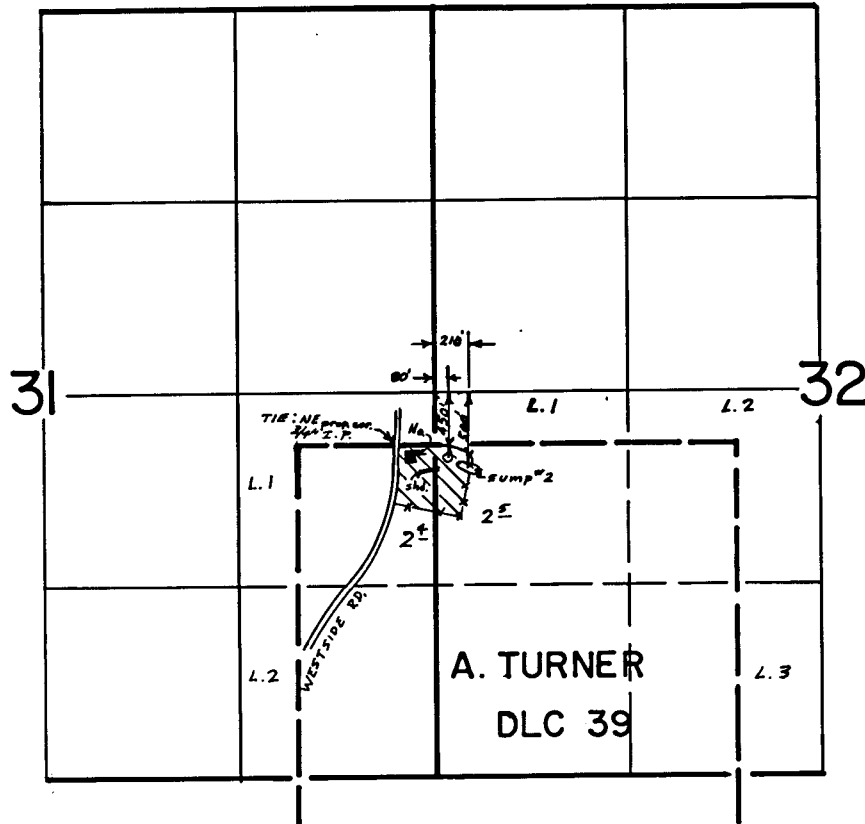

FINAL PROOF SURVEY
UNDER

Application No. G:5920 Permit No. G:5628...
IN NAME OF

RONALD...C... & KATHRYN...DAVISON

Surveyed May...1... 19.80, by BRUCE...R...SUND