


T. 39S., R. 8 W., W.M.

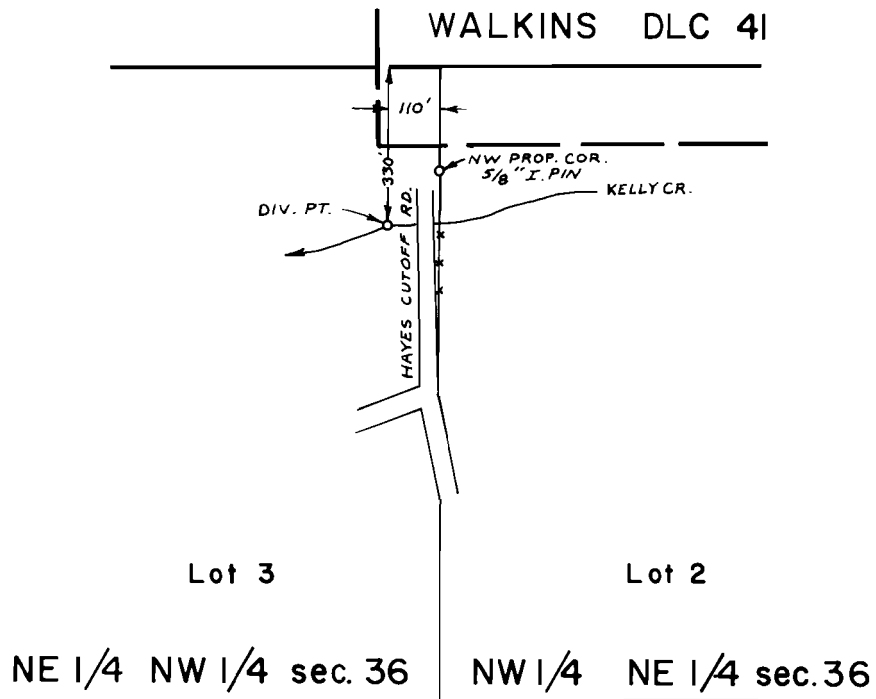

Scale 1" = 400'

FINAL PROOF SURVEY UNDER

Transfer no. S-184

Application No. Permit No.
IN NAME OF

..... CLIFFORD SOWELL

Surveyed April 30, 1980, by B.R. SUND