


T. 9S., R. 40E., W. M.

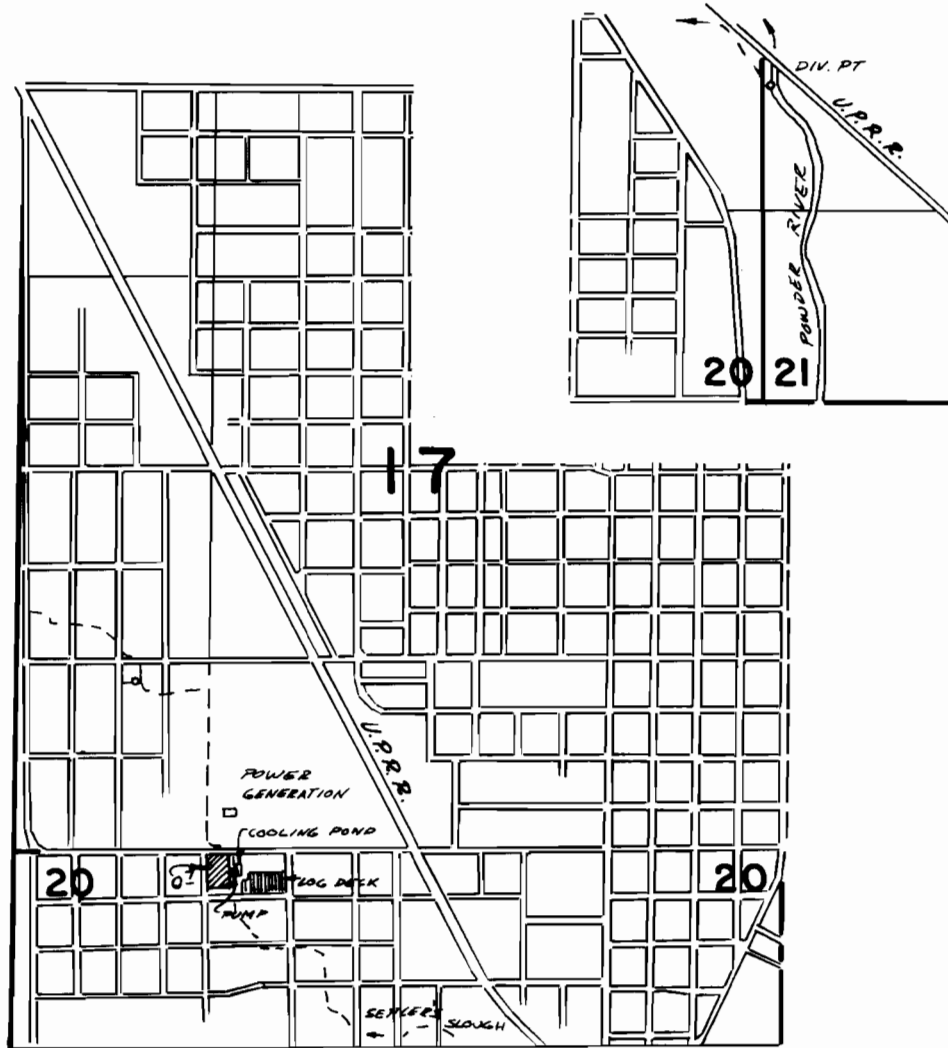

DIV. PT. LOCATED 2180' N + 55' E FROM SW COR SEC 21

FINAL PROOF SURVEY

UNDER

TRANSFER 4309

50923 37115

Application No. **59428** Permit No. **44685**

IN NAME OF

.....**ELLINGSON LUMBER CO.**.....

Surveyed *DEC. 11* 19*51*, by *Thomas L. Church*