


T. 7S. R. 38E., W. M.

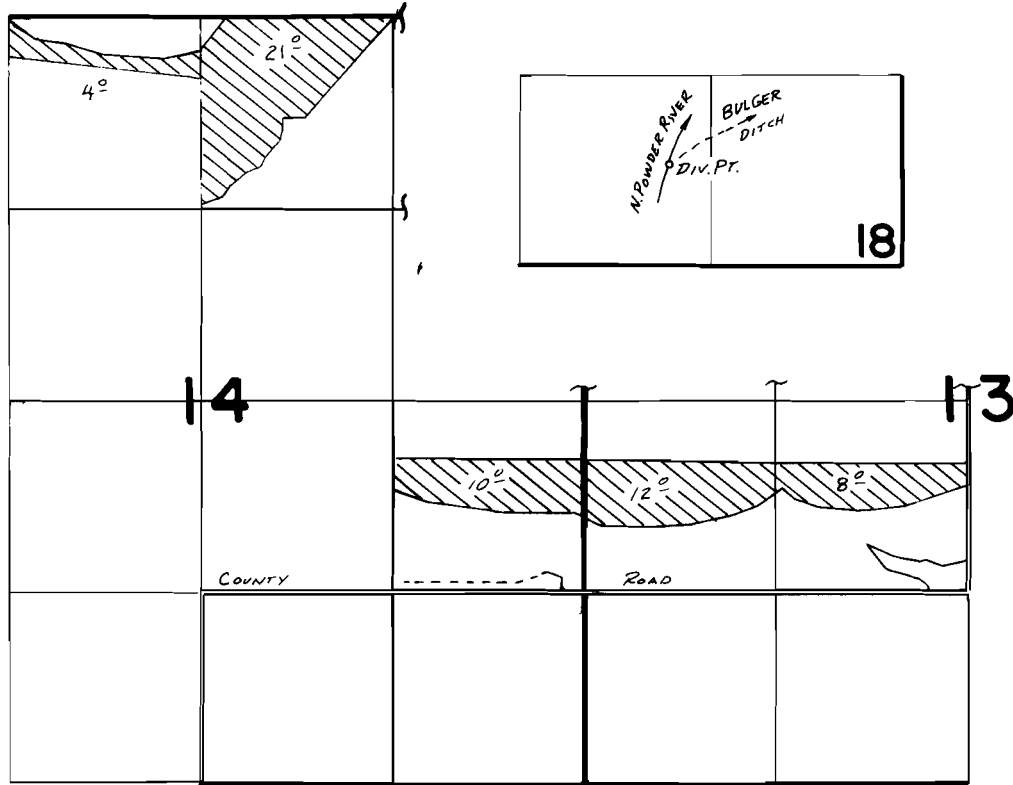

DIV. PT. LOC. 700' N. & 1620' W. FROM SEC. COR. SEC. 18

FINAL PROOF SURVEY
UNDER

Application No. **61686** Permit No. **45921**.....
IN NAME OF

.....**ISABEL W. BOYD**.....

Surveyed **4-15**..... **1982**, by **V.L. Church**.....