


# T.8S.,R.46 & 47E.,W.M.

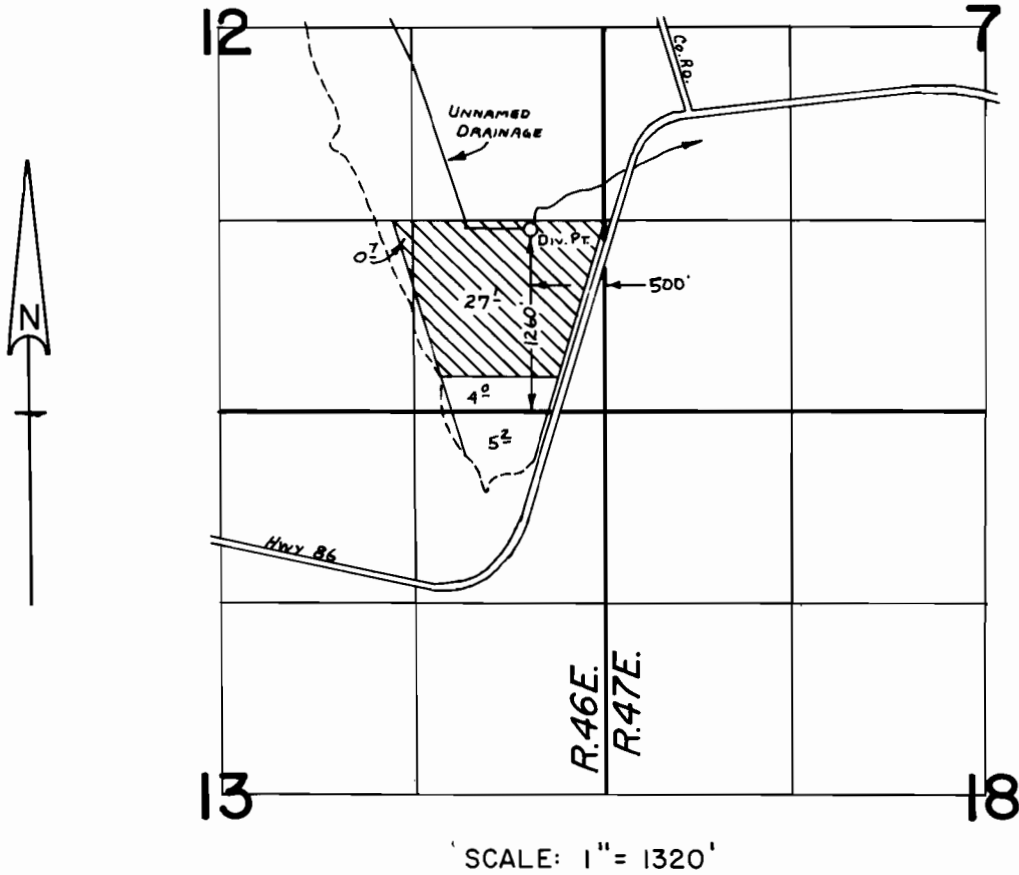

## FINAL PROOF SURVEY UNDER

Application No. .60088. Permit No. .47930.....  
IN NAME OF

**TERRY STROMER**

Surveyed Aug. 29, 1985, by L. M. TOLL.....