


T. 9S., R. 40E., W. M.

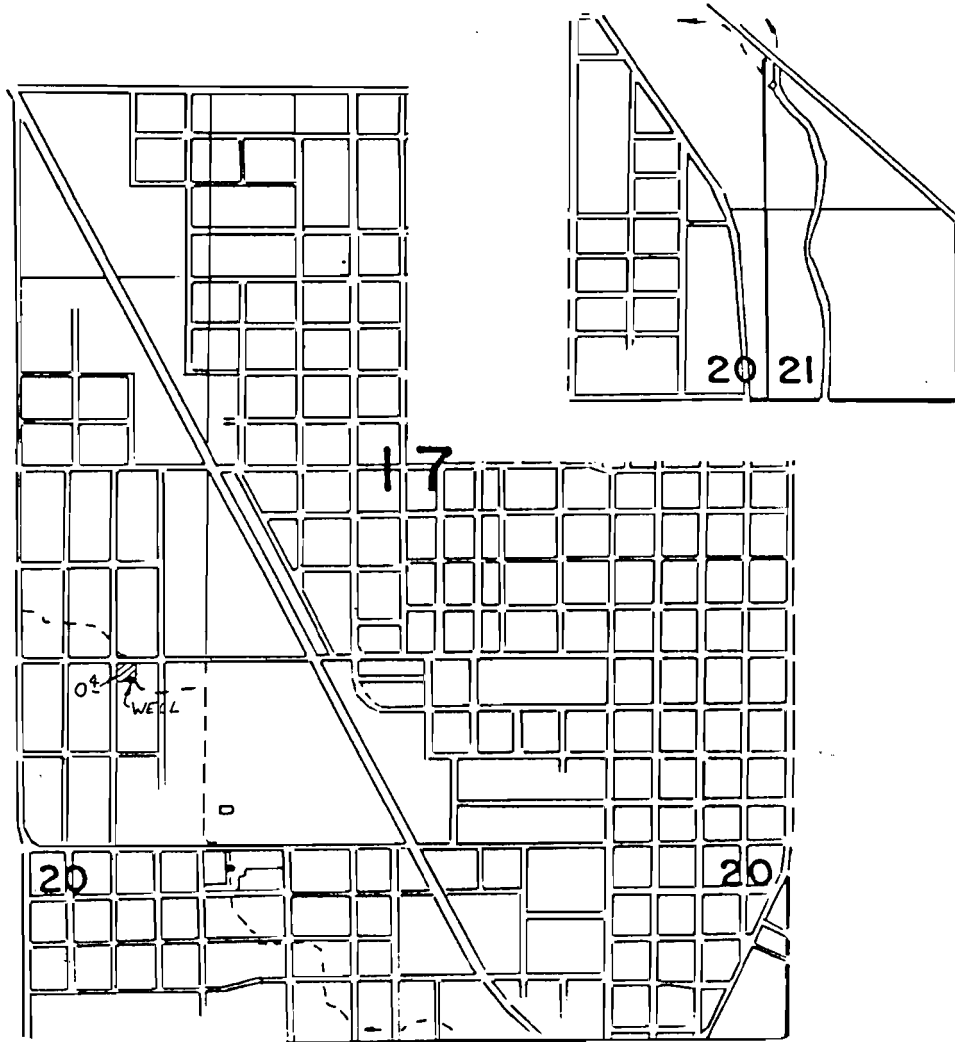

WELL LOCATED 1150' N & 750' E FROM SW COR SEC. 17

FINAL PROOF SURVEY
UNDER

Application No. G-8840 Permit No. G-8237
IN NAME OF

FLOYD SCHIMA

Surveyed July 26, 1979, by Vernon L. Church