


# T.12S.R.4W.W.M.

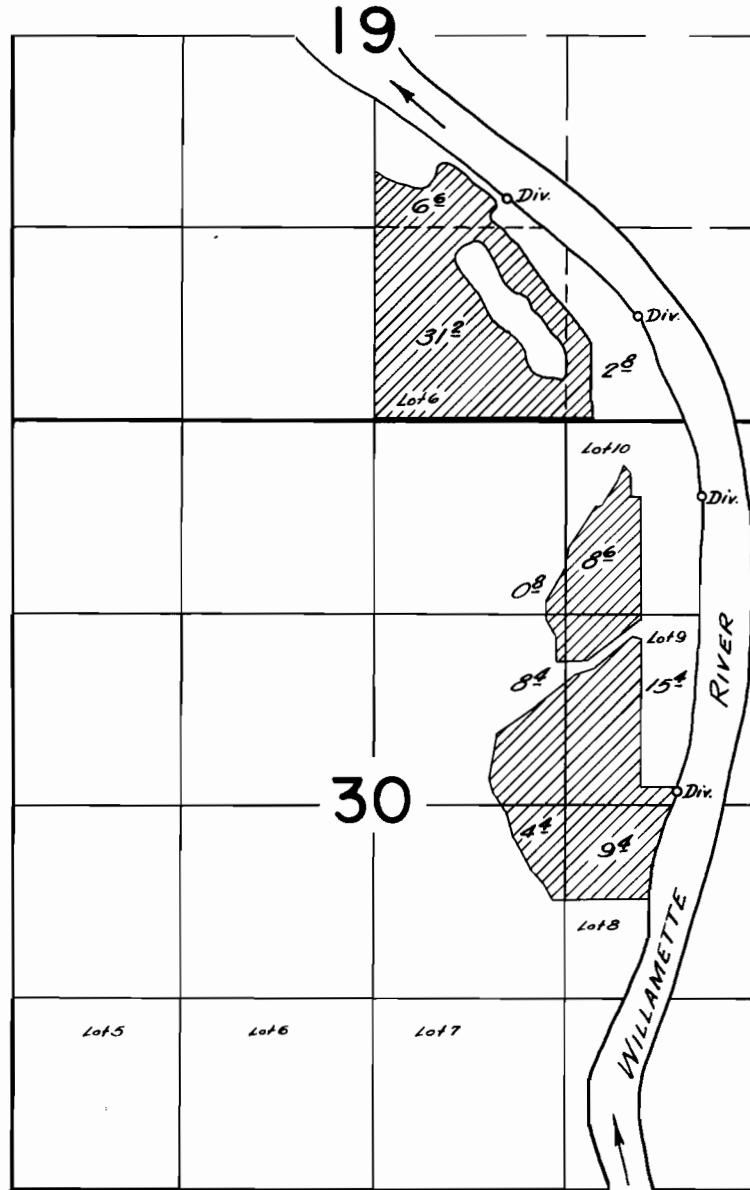

## FINAL PROOF SURVEY UNDER

Application No. 32510 Permit No. 25683  
IN NAME OF

**Melvin Williamson, et al**

Surveyed June 1, 1961, by C.O. Bartels