


T. 4 S., R. 1 E., W.M.

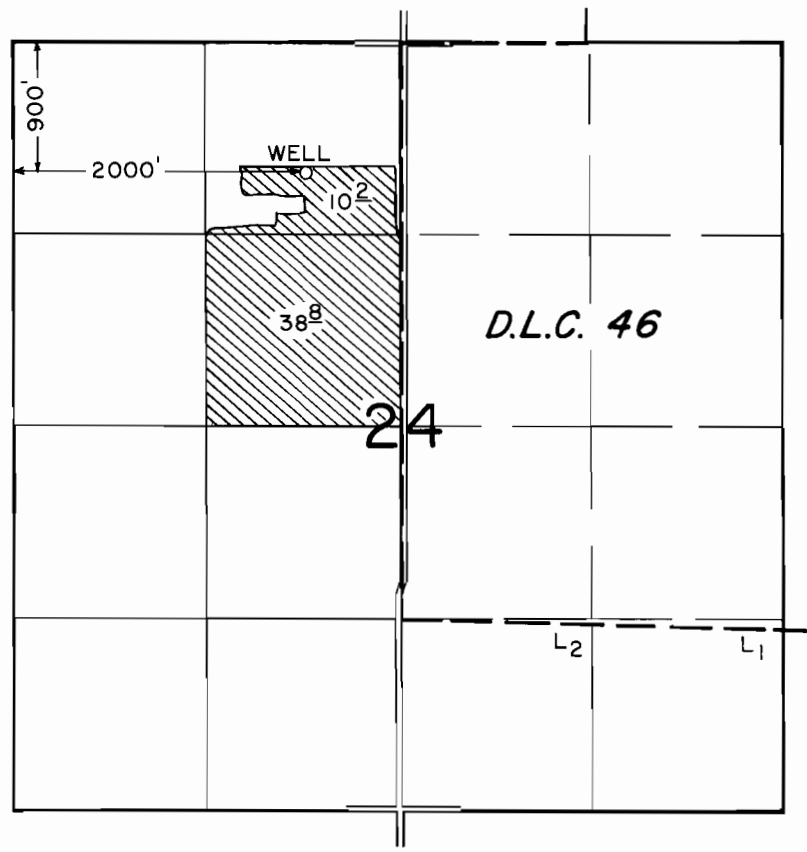

SCALE: 1" = 1320'

**FINAL PROOF SURVEY**  
UNDER

Application No. G-10670 Permit No. G-9620....  
IN NAME OF

.....RUFUS K. KRAXBERGER.....

Surveyed JULY 9, 1985, by T. WARREN.....