


RECEIVED

AUG 12 1981

WATER RESOURCES DEPT
SALEM, OREGON

TGN. RLOW. WM.

Application No. 62217
Permit No. 46408

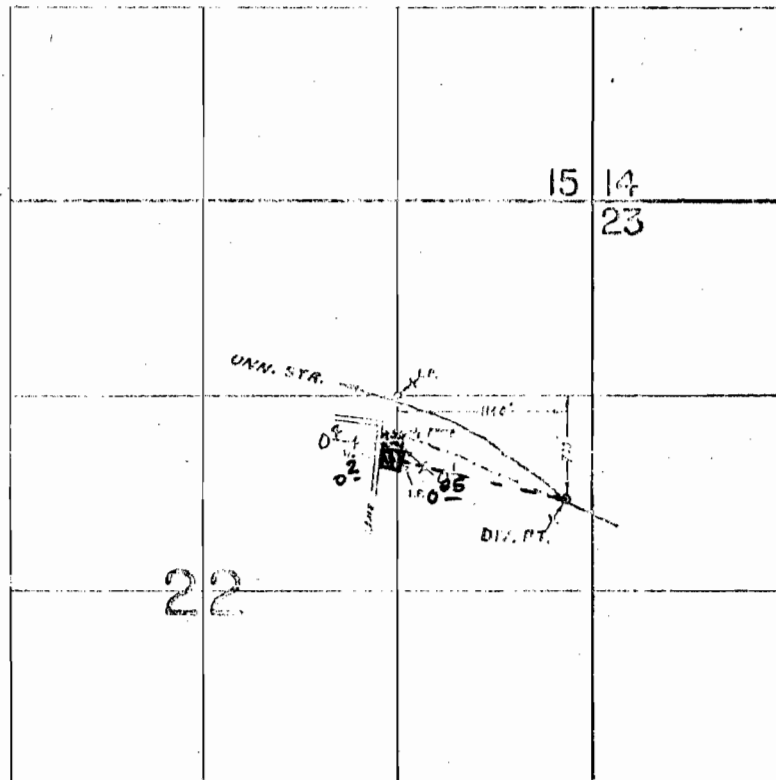

FINAL PROOF SURVEY
UNDER

~~Application No. 47358 Permit No. 95117~~

~~IN NAME OF~~

~~HENRY C. DESLER~~

~~Surveyed APRIL 30, 1973, by R. MUCKEN~~