


T.13S.,R.29E.,W.M.

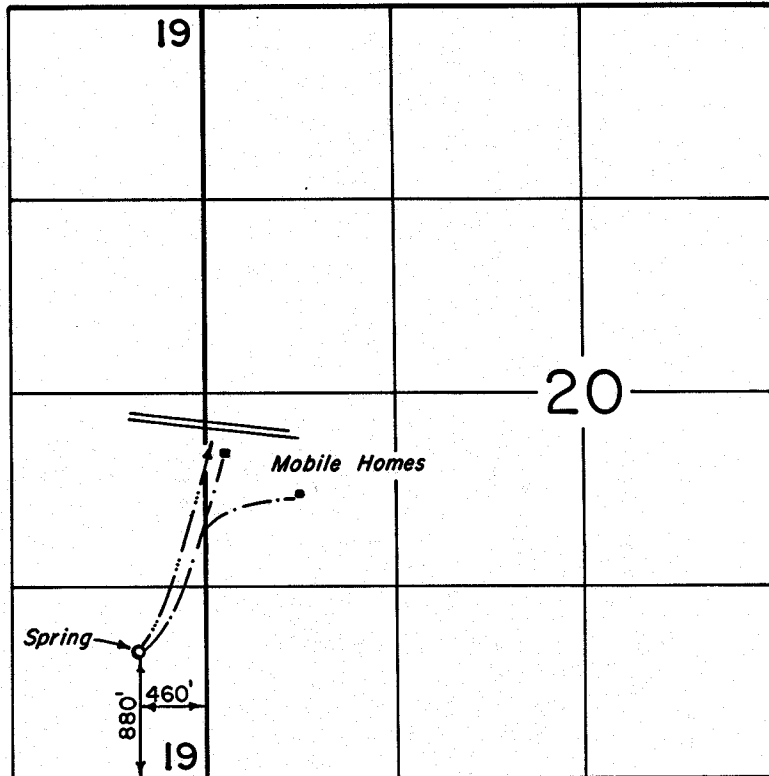

FINAL PROOF SURVEY UNDER

Application No. 59447 Permit No. 44681

IN NAME OF

LARRY & SHERRIE OSBORNE

Surveyed SEPT. 2, 1981, by *dBrown*