


47416
C-54995

T.11&12S. R.29&30E. W.M.

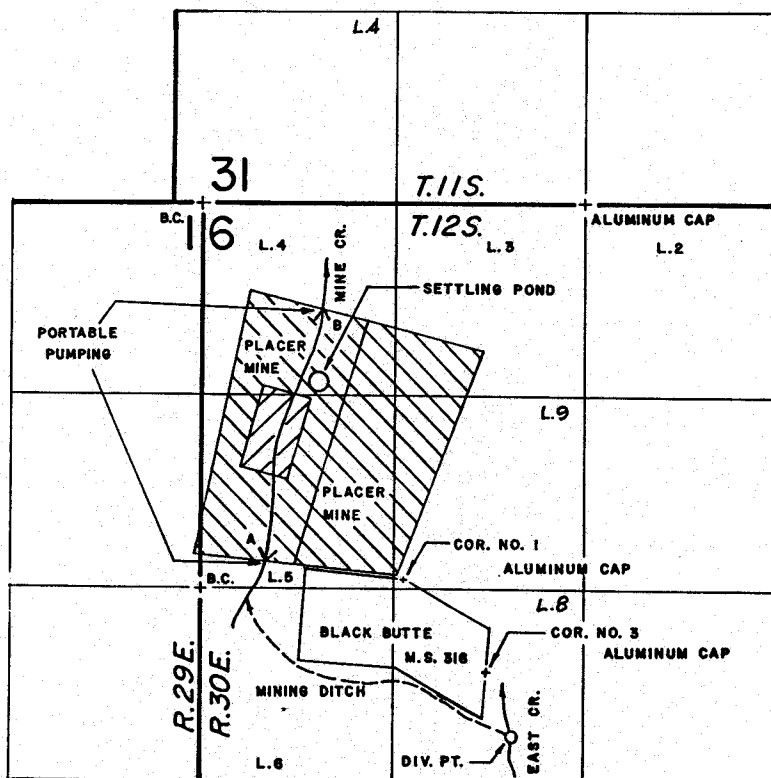

EAST CR. DIV. PT. IS LOCATED 3630 FT. S. AND 2170 FT. E. FROM THE N.W. COR. OF SEC. 6.

MINE CR. DIV. PT. IS LOCATED BETWEEN PT. A, 2440 FT. S. AND 450 FT. E., AND PT. B, 710 FT. S. AND 850 FT. E., BOTH FROM THE N.W. COR. OF SEC. 6.



FINAL PROOF SURVEY UNDER

SCALE: 4" = 1 MILE

Application No. 63840 Permit No. 47416
IN NAME OF

RAY HARPER

Surveyed AUG. 7, 1984, by P. P. Patten