


47 71701

T.3N.,R.1E.,W.M.

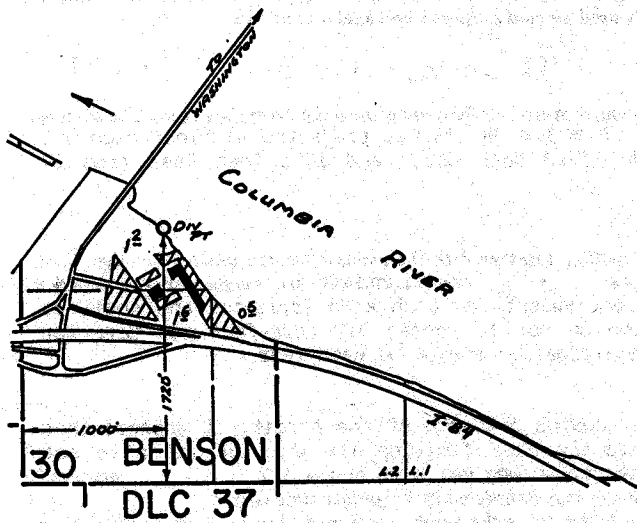

**FINAL PROOF SURVEY**  
 UNDER

Application No. 55319... Permit No. 41487.....  
 IN NAME OF

.....**THE HOOD RIVER INN**.....

Surveyed April 16, 1980, by R.G. MUCKEN.....