


T. 6 S., R. 10 W., W.M.

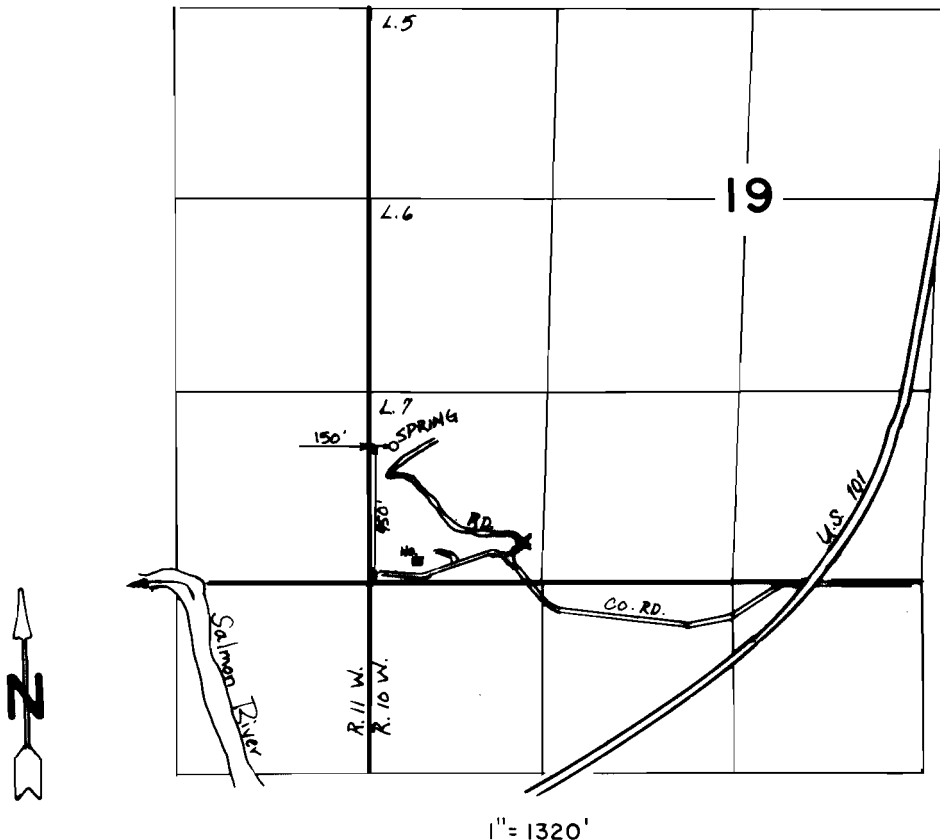

FINAL PROOF SURVEY
UNDER

Application No. 56630 Permit No. 42092.....
IN NAME OF

FRANCES X. EVANS & JOHN OTTO BECKER

Surveyed OCT. 31, 1983, by M. CAHILL.....