


T.9S.,R.3E.,W.M.

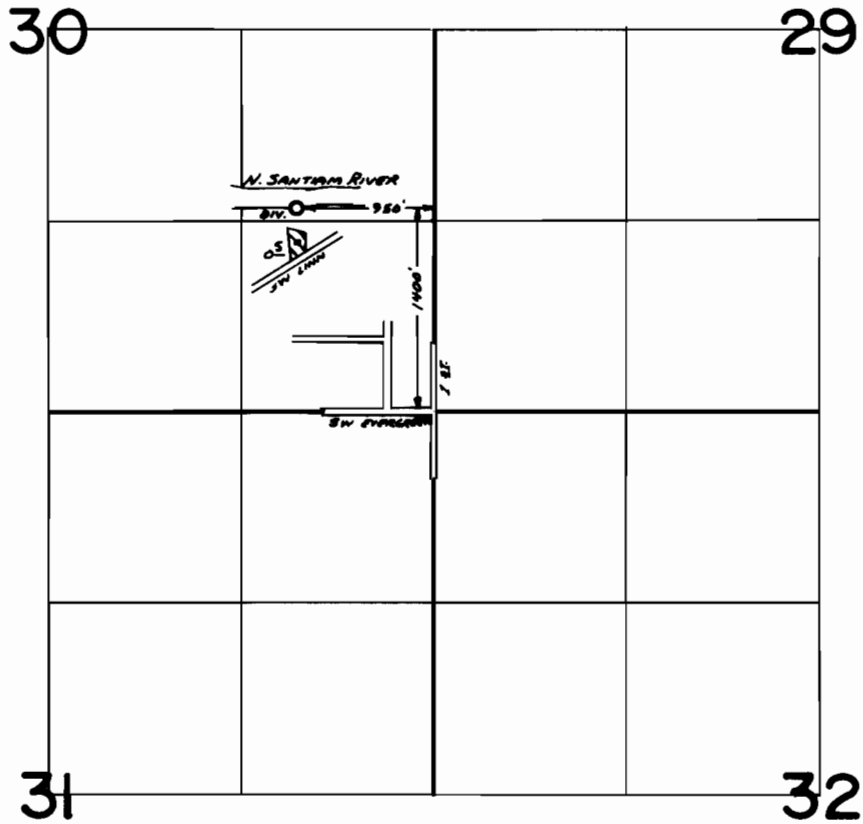

FINAL PROOF SURVEY
UNDER

Application No. 59487. Permit No. 44882.....

IN NAME OF

D. STANLEY CHANCE

Surveyed July 31, 1981, by L. TOLL.....