



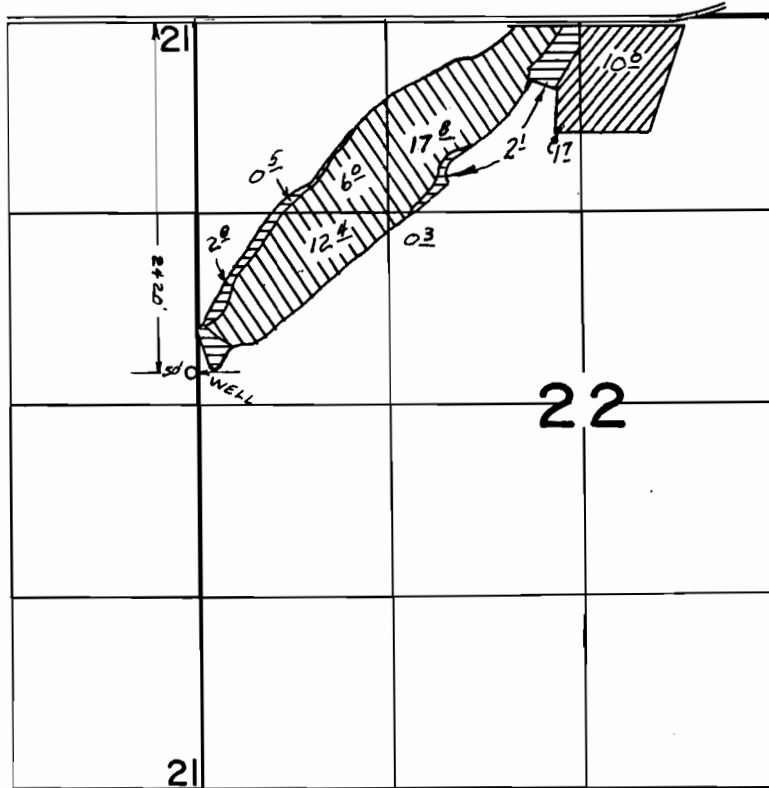


T14S. R.39E. W.M.

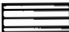

FINAL PROOF SURVEY
UNDER

G-10636 G-9926
 Application No. G-7094 Permit No. G-6562
 IN NAME OF

Suppl. Primary
 
 

STEVE COLEMAN
 AUG 23 1985 L.M. TOLL
 Surveyed JUN 23 1978, by L.H. NUNN