


T. 2N., R. 32E., W.M.

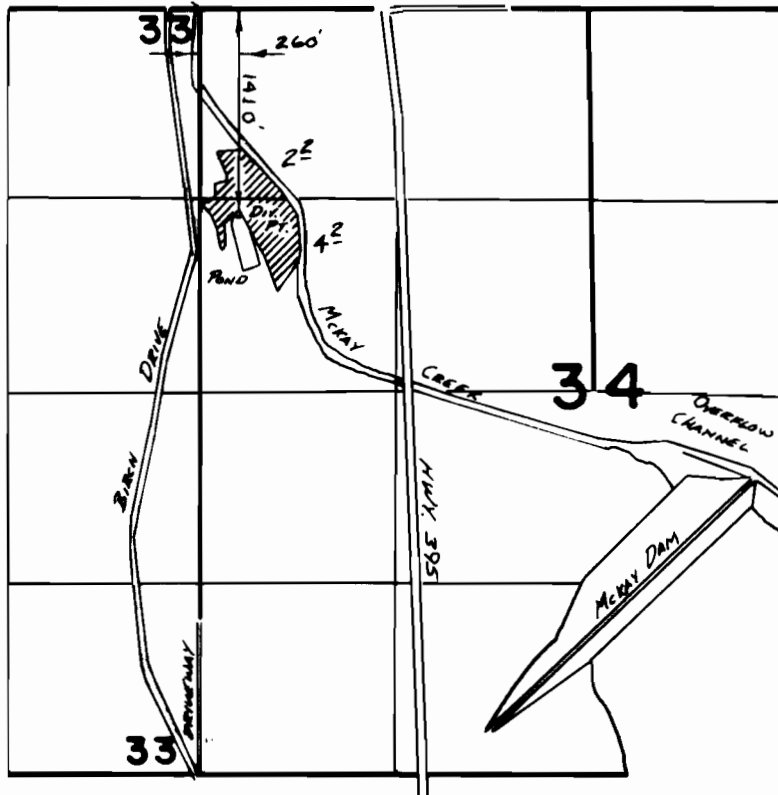

FINAL PROOF SURVEY

UNDER

Application No. **50543**. Permit No. **38161**.....
IN NAME OF

.....**DAVID**.....**McKENNA**.....

Surveyed **JULY 8**... 19**81**., by **V. CHURCH**.....