


G-6865
55010

T. 5N. R. 32E. W.M.

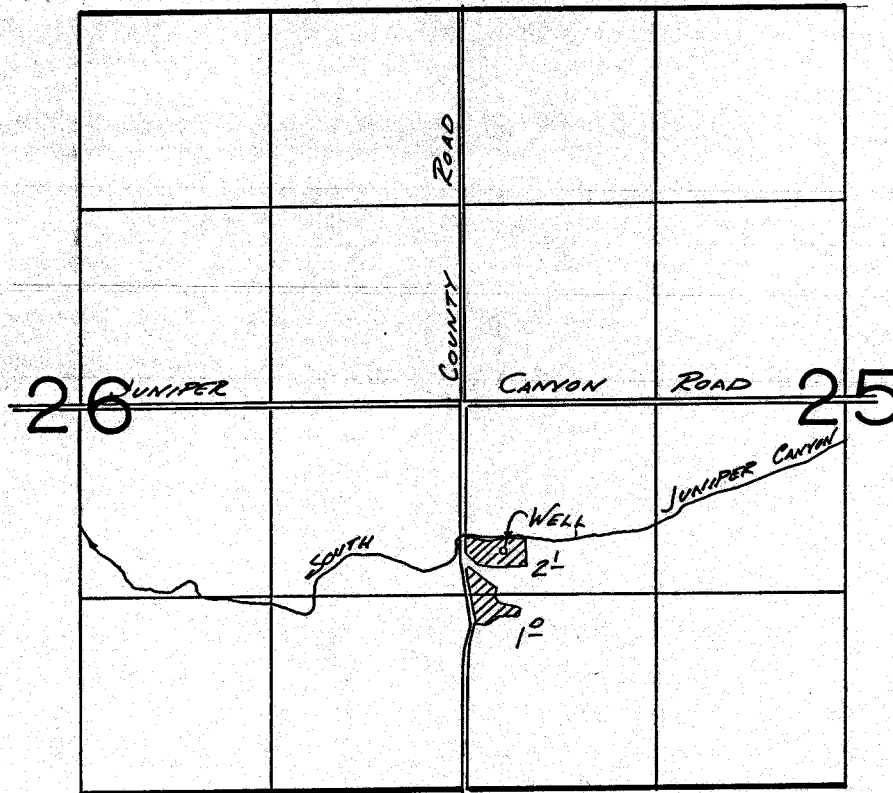

WELL LOCATION 1610' N. & 300' E FROM SW COR
SEC. 25

FINAL PROOF SURVEY
UNDER

Application No. G-7336 Permit No. G-6865
IN NAME OF

..... McRAE RANCH

Surveyed JULY 29, 1982, by V. CHURCH.....