


T. 6N., R. 36E., W.M.

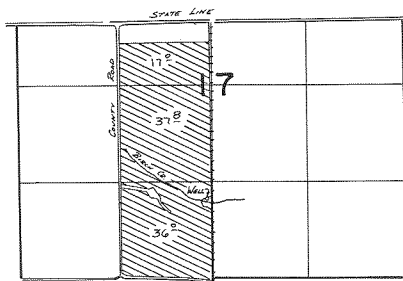

Well located 1060' N / 2740' W. FROM SE COR. SEC 17

FINAL PROOF SURVEY
UNDER

Application No. G-2105. Permit No. G-8618....
IN NAME OF

Vito A. MORAMARCO

Surveyed June 28, 1982., by V. LUKSEN.....