
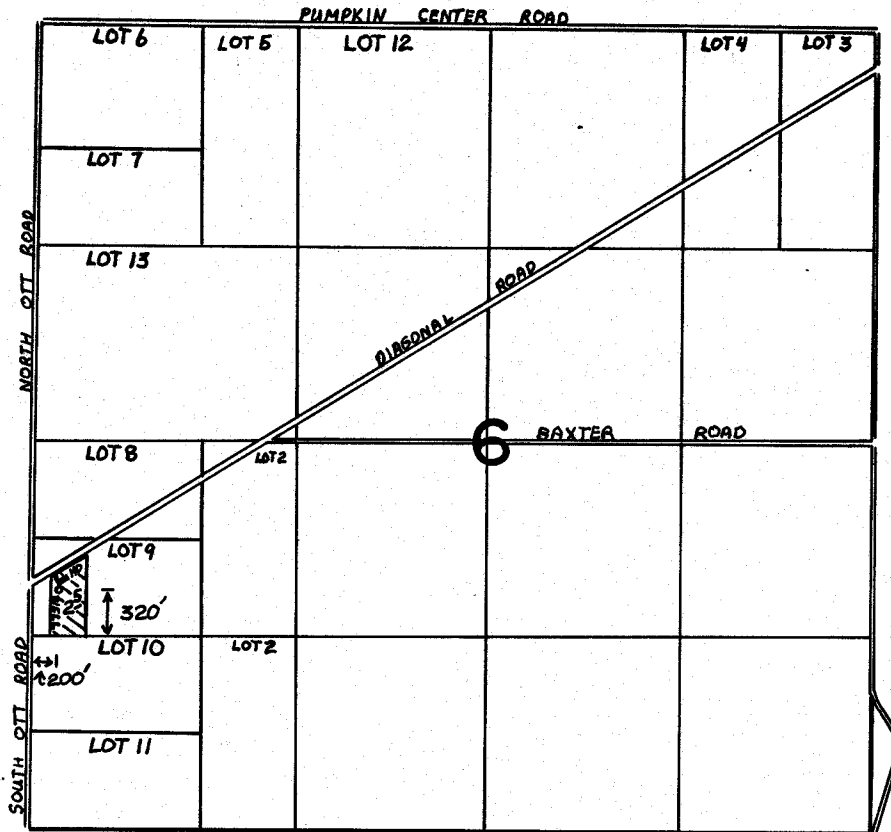


T.4 N., R.29 E., W.M.

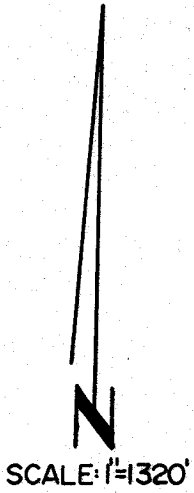

FINAL PROOF SURVEY UNDER

Application No. G-9552 Permit No. G-9403.....

IN NAME OF

GEORGE G. 3 NORENE DODSON

Surveyed *March 26*, 19*86*., by *V.L. CHURCH*.....