


T. 6N., R. 35E., W. M.

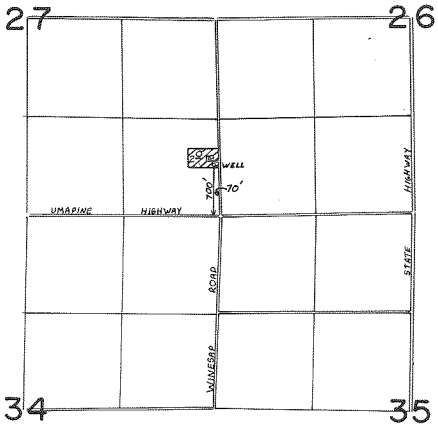

FINAL PROOF SURVEY

UNDER

Application No. G-10628 Permit No. G-9737.....
 IN NAME OF

LARRY E. HARSHMAN.....

Surveyed MARCH 25, 1986, by V.L. CHURCH.....
 JS