


G 10212

55071

# T. 6 N. R. 35 E. W. M.


SCALE: 1"=1320'

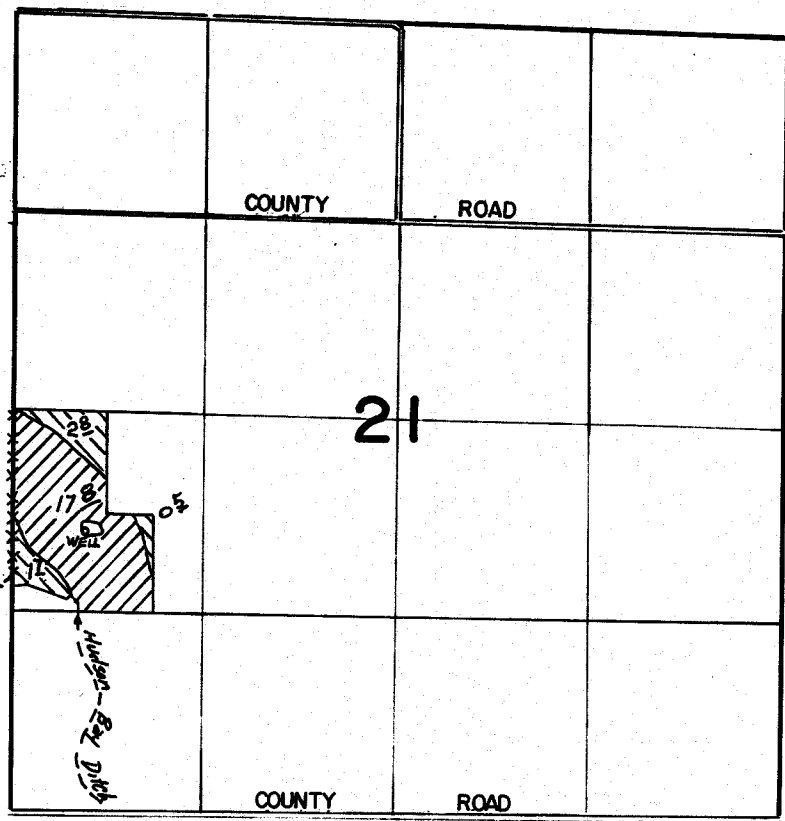

WELL LOCATED 820'S. AND 500' E. FROM W. 1/4 COR. SEC. 21



PRIMARY

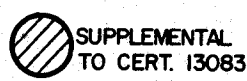

SUPPLEMENTAL TO CERT. 13083

## FINAL PROOF SURVEY UNDER

Application No. G-1054... Permit No. G-10212...  
IN NAME OF

**JAMES ELLERY ALEXANDER**

Surveyed ~~Sept. 19~~..... 1985., by ~~V.A. Church~~.....