

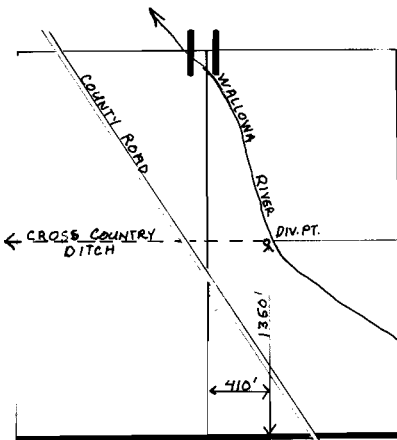


T. 1 S., R. 43 E., W. M.

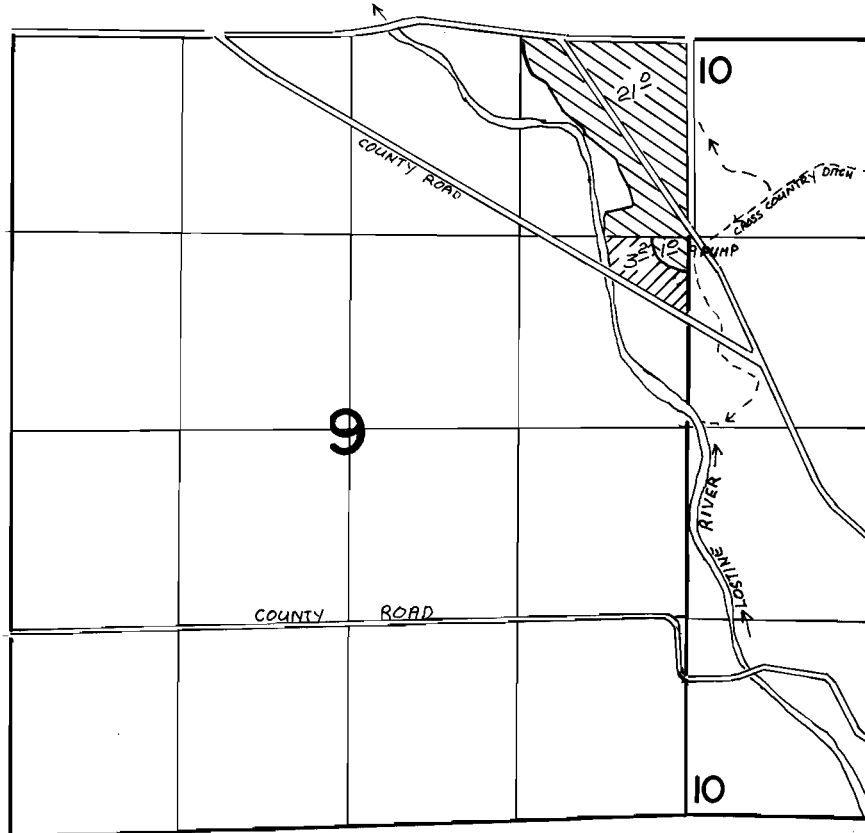

Primary

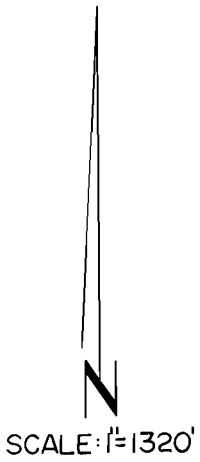

Supplemental

FINAL PROOF SURVEY UNDER

Application No. 53195... Permit No. 39472.....
IN NAME OF

JOHN L. MAGDEN

Surveyed Aug. 28..... 1978., by R. BARWIN.....