


T.2S., R.45E., W.M.

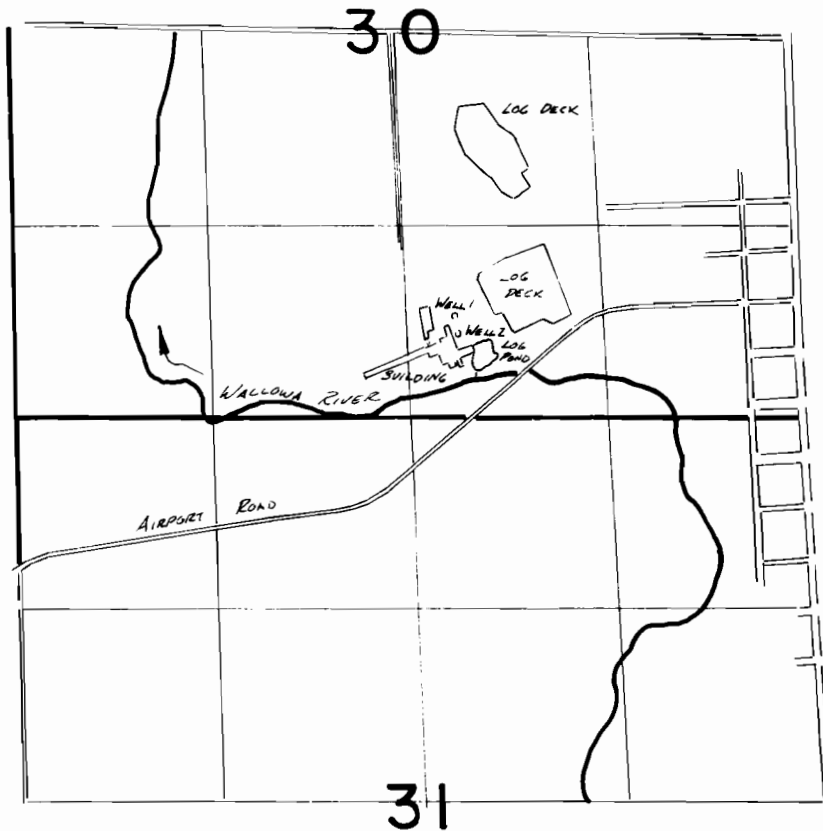

WELL 1 LOC: 700' N. & 340' E. FROM SW COR. SEC 30
WELL 2 LOC: 580' N. & 35' E. FROM SW COR. SEC 30

FINAL PROOF SURVEY
UNDER

Application No. **G:6435** Permit No. **G:6026**...
IN NAME OF

BOISE CASCADE CORP.

Surveyed *Aug. 11*..... 19*82*., by *V.L. Church*.....